
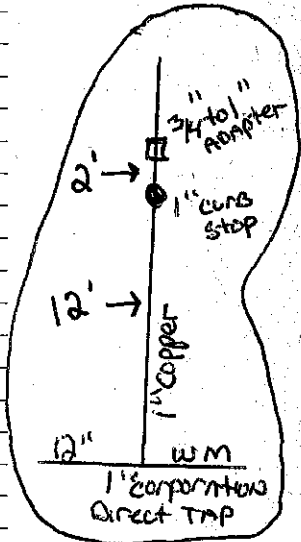


DATE 10/21/20

TOWN OF LEXINGTON — BOARD OF PUBLIC WORKS

WATER DIVISION

Sketch of Service Here

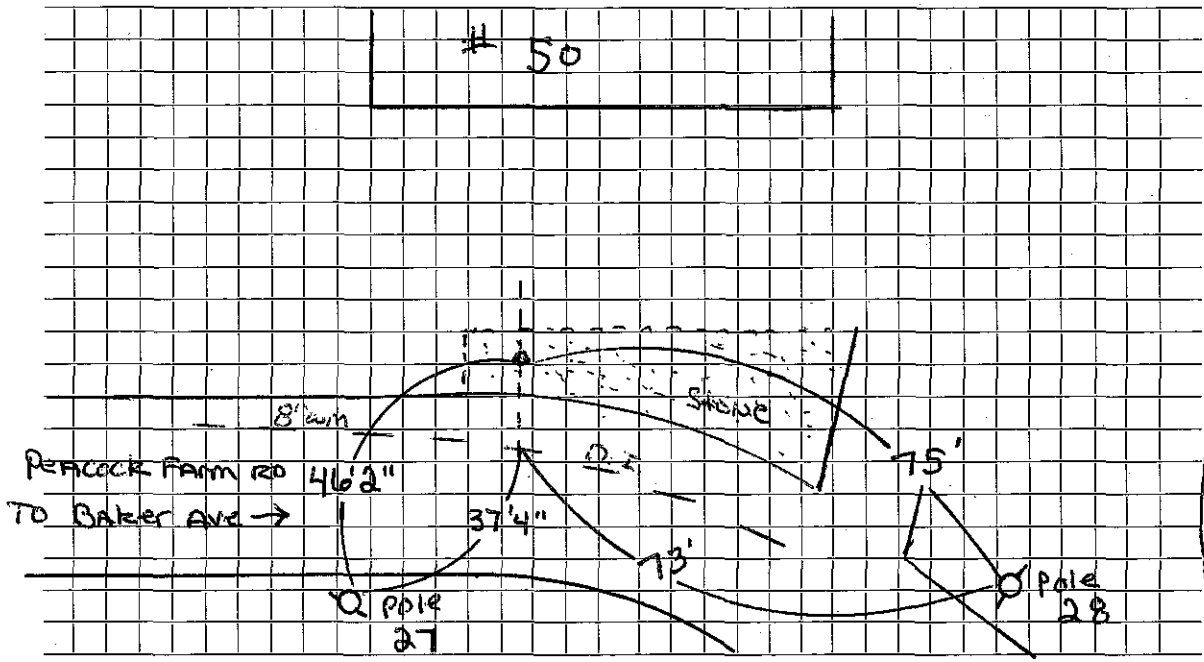

Connection made in Street. Work completed Installed. new main to curb stop...

Remarks:
.....
.....