


DATE 10/22/20

TOWN OF LEXINGTON — BOARD OF PUBLIC WORKS

WATER DIVISION

Sketch of Service Here

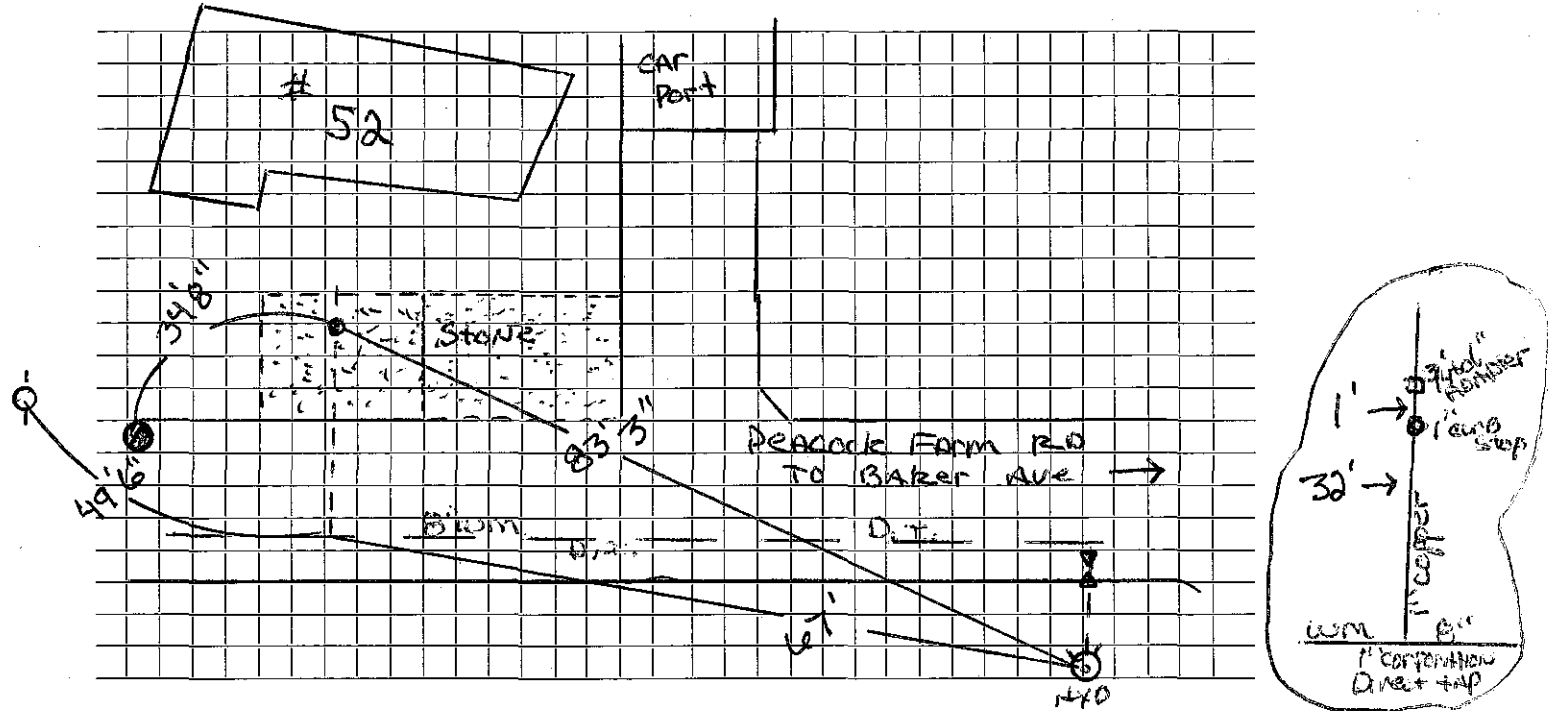

Connection made in Street. Work completed INSTALLED NEW MAIN TO CURB STOP.....

Remarks:
.....
.....