
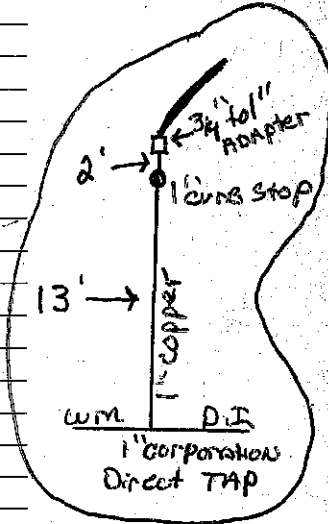


DATE 10/22/20

TOWN OF LEXINGTON — BOARD OF PUBLIC WORKS

WATER DIVISION

Sketch of Service Here

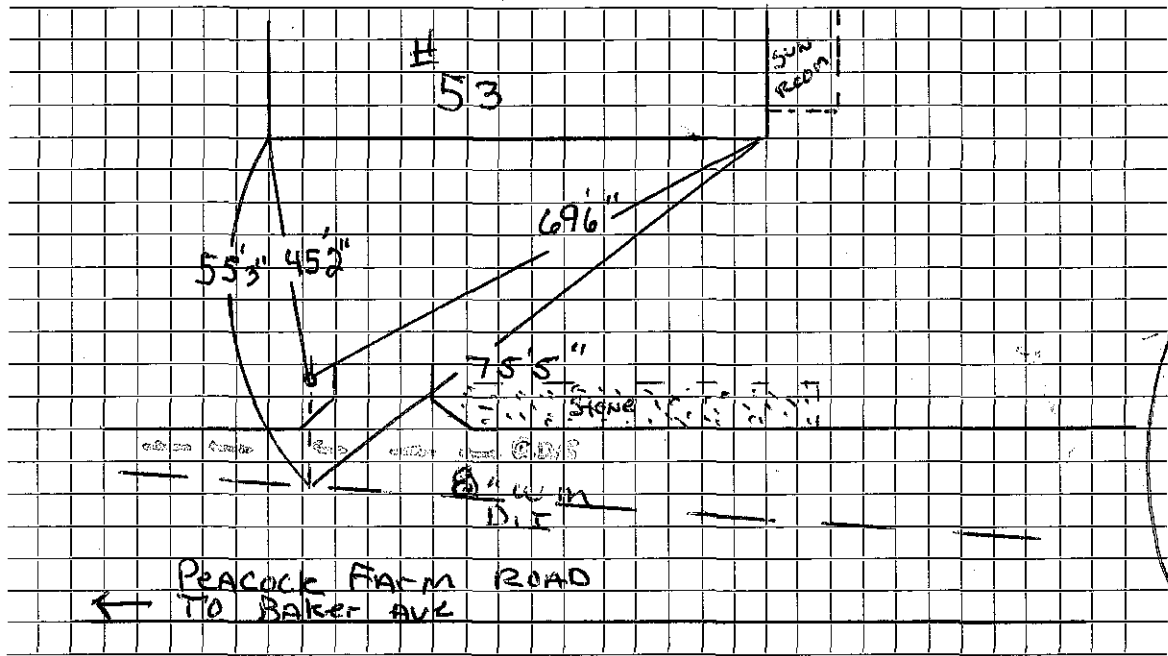

Connection made in Street. Work completed Installed. new. mmn to curb. stop.

Remarks:

.....

.....