

## WATER SERVICE RECORD

Name Benjamin Franklin Homes, Inc.

Service No. 316 (1955)

Address 6 Peacock Farm Rd.

Location Lot 3

Repair—Renewal—New Service


Date	Material	Amount	Total	Date	Amount	
9/8/55	Labor	1 90		9-23-55	Deposit	\$ 30 00
	10% overhead	19	2 09	8-20-56	Paid	17 32
	65' - 3/4" copper tubing @.56		36 40		<u>NON CHARGE</u>	47 32
	1 - 3/4 x 1/2 3 part Union		3 12	1 1/2	Straight tail piece	50
	1 hr. trucking @.75		75	1 1/2	Offset tail piece	50
	1 - 3/4 C x 1/2 I.W.H. stop&waste		4 96			1 00
			47 32	11-18-53	Labor	5.91
					10' 3/4" Copper tubing @.3629	3.63
					1 3/4" C Corp Cock	4.33
					1 3/4" C Gurb Cock	4.67
					1 box & Rod	3.90
					1 hr. Trucking	75
						24.19

DATE \_\_\_\_\_

# TOWN OF LEXINGTON — BOARD OF PUBLIC WORKS

## WATER DIVISION

Sketch of Service Here

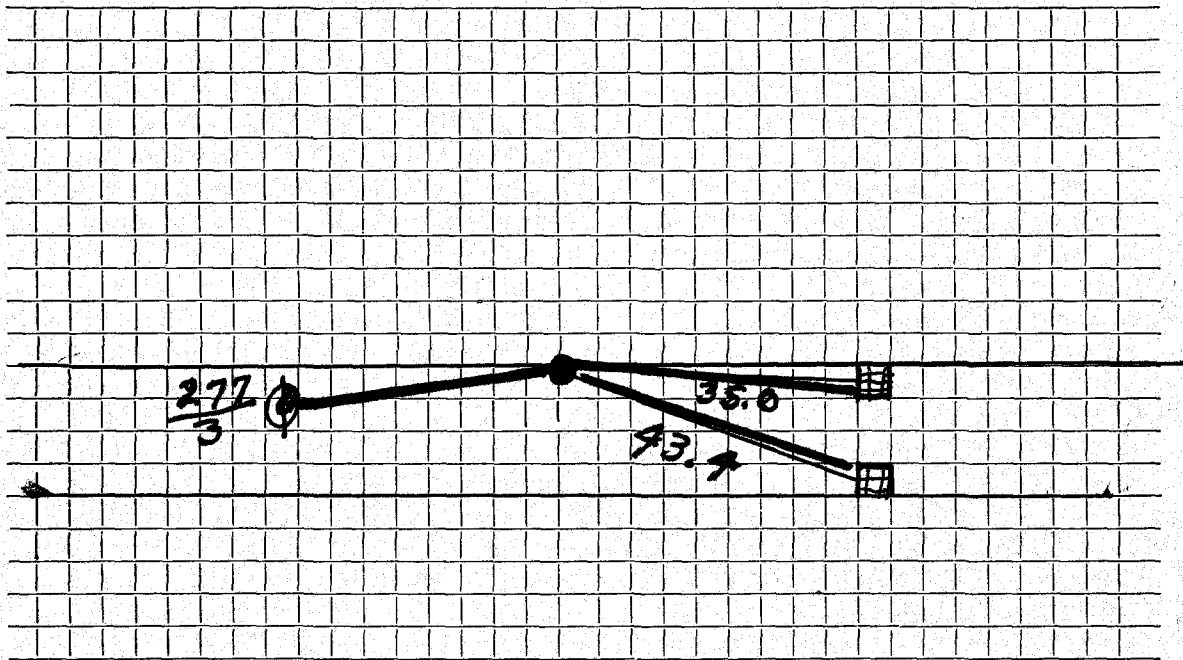

Connection made in ..... Street. Work completed .....

Remarks: .....  
.....  
.....