

## WATER SERVICE RECORD

Name Benjamin Franklin Homes, Inc.

Service No. 141

Address 8 Peacock Farm Road

Location Lot 4

Comm. 11-19-56

~~Remarks~~ - New Service

Service in to curb


Date	Material	Amount	Total	Date	Amount	
6/11/56	Labor	12 06.		6-8-56	Deposit	75 00
	10% overhead	1 21	13 27	11-19-56	Refund	33 71
	46' - 3/4" Copper tubing @.4850	22 31			NON CHARGE	41 29
	1 - 3/4" Cx 1/2 I.W.H. Stop & Waste	4 96			1 - 1/2 Straight tailpiece	50
	1 hr. trucking		75		1 - 1/2 Offset tailpiece	50
			41 29			1 00
				11-18-53	Labor	5.91
					12' 3/4" Copper tubing @.3629	4.35
					1 3/4" C Corp Cock	4.33
					1 3/4" C Curb cock	4.67
					1 box & rod	3.90
					1 hr. Trucking	75
						23.91

DATE \_\_\_\_\_

TOWN OF LEXINGTON — BOARD OF PUBLIC WORKS

**WATER DIVISION**

Sketch of Service Here

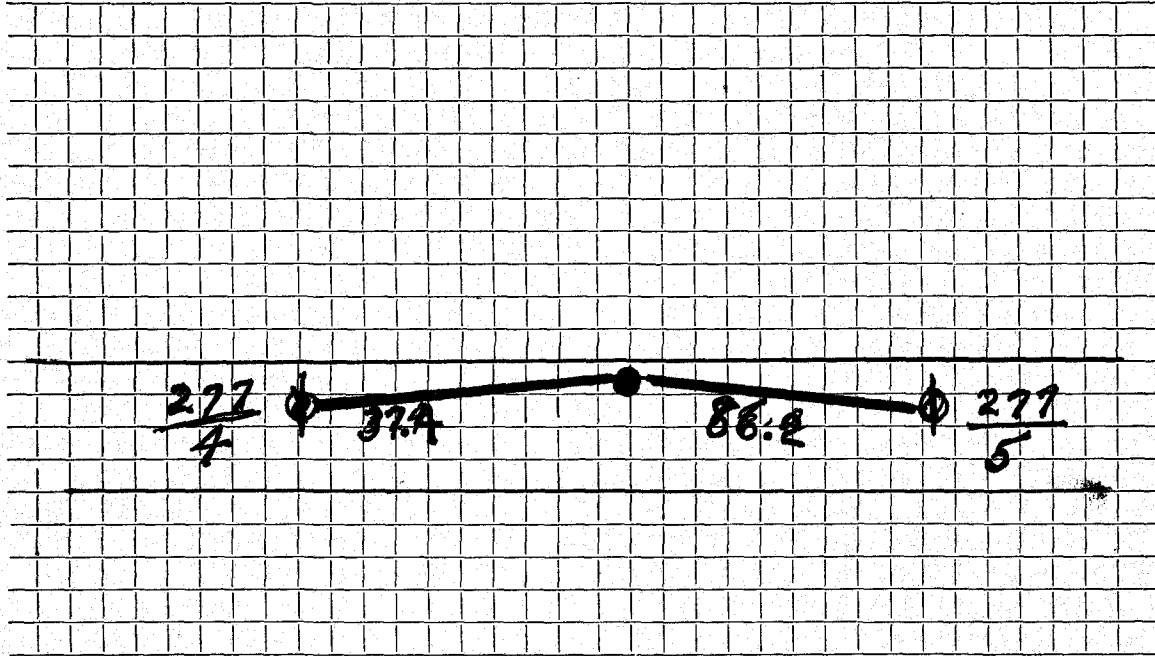

Connection made in ..... Street. Work completed .....

Remarks: .....

.....

.....