

## WATER SERVICE RECORD

#6035

Name Cambridge Corp.

Service No. 251

Address 9 Peacock Farm Road

Location

~~Repair Work~~ - New Service

Com 11-9-53


Date	Material	Amount	Total	Date	Amount
8/25/53	Labor	1 75		8-25-53	50 -
	10% overhead	18	1 93	11-9-53	(3 50)
	105' -3/4" copper tubing@.3629		38 10		NON CHARGE: 46 50
	1 -3/4"C x 1/2 I.W.H. stop & waste		4 00	10/2/53	Labor 9 00
	1 - 3/4"C x 3/4"C. union		1 72		24' - 3/4" copper tubing@.3629 8 71
	1 hr. trucking		75		1 - 3/4"C. corp-cock 4 33
			46 50		1 - 3/4" x 3/4" C. curb-cock 4 67
	TRENCH DUG BY OWNER:				1 box and rod 3 90
					1 - 1/2 straight tail pc. 50
					1 - 1/2 offset tail pc. 50
					2 hrs. Littlefield shovel@ 7.50 15 00
					1 hr. trucking 75
					47 36
				5-1-62	Labor 2.45
					1' 3/4" Copper tubing @.42 .42
					1 3/4" C Curb Cook 6.28
					1 3/4 Style 88 Repair Clamp 2.90
					(Broken by contractor) 12.05

DATE \_\_\_\_\_

TOWN OF LEXINGTON — BOARD OF PUBLIC WORKS

**WATER DIVISION**

Sketch of Service Here

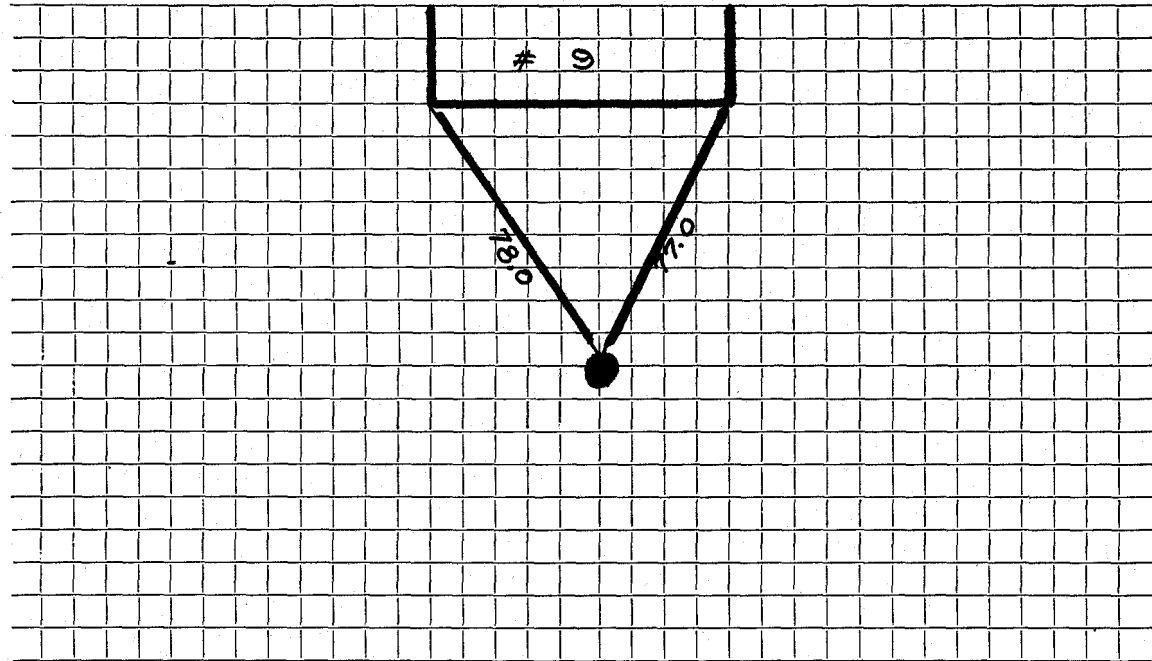

Connection made in ..... Street.      Work completed .....

Remarks: .....  
.....  
.....