


DATE 4/8/85

TOWN OF LEXINGTON — BOARD OF PUBLIC WORKS

WATER DIVISION

Sketch of Service Here

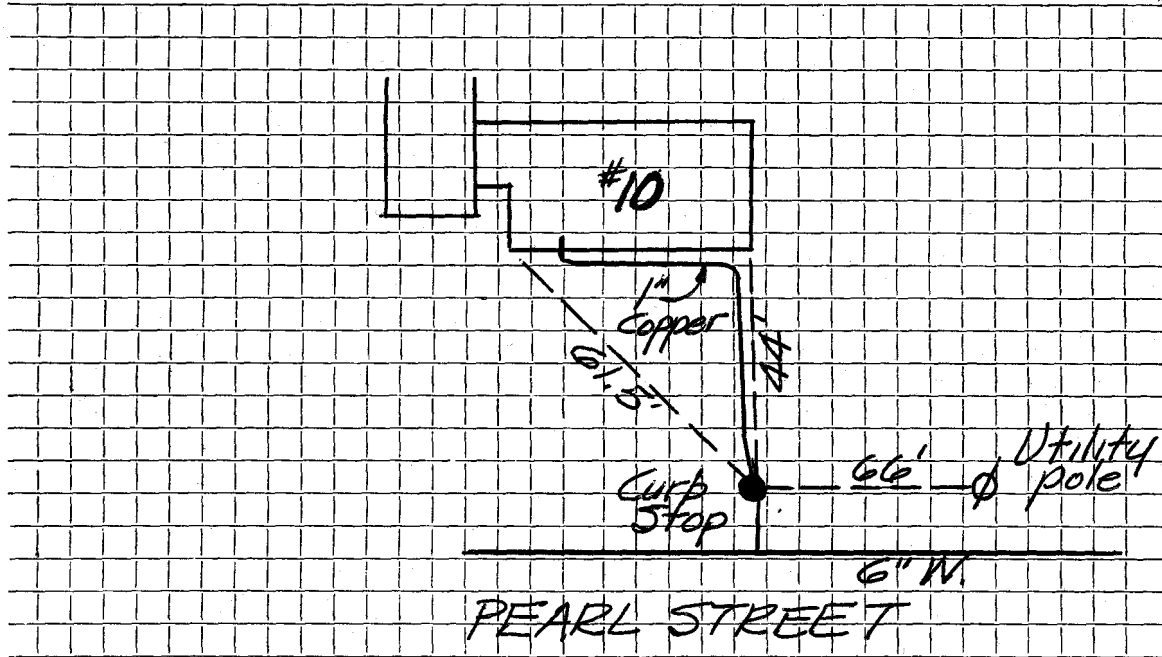

Connection made in Pearl Street. Work completed

Remarks: Unaccepted Street Built By R. Mabary - All Work Done By Owner Nov 1984