

## WATER SERVICE RECORD

# 4882

Name Leo Enrigo

Service No. 87

Address 11 Pearl Street

Location

~~Repair Record~~ New Service W.O. #8164


Comm 2-10-64

Date	Material	Amount	Total	Date	Amount
9/9/63	Labor	2 13		8-27-63	Deposit 50 00
	10% O.H.	21	2 34	2-10-64	Retained 24 27
	41' 3/4" Copper Tubing @ .42		17 22		25 73
	1 3/4" Cx 1/2 I.W.H. Stop & Waste		6 17		
			25 73	9/9/63	Labor 2 31
					25' 3/4" Copper Tubing @ .42 10 50
					1 3/4" C Corp Cock 4 91
					1 3/4" C Curb Cock 6 28
					1 Bow & Rod 4 90
					1 1/2 Straight Tailpiece 50
					1 1/2 Offset Tailpiece 50
					<u>29 90</u>

DATE \_\_\_\_\_

TOWN OF LEXINGTON — BOARD OF PUBLIC WORKS  
**WATER DIVISION**

Sketch of Service Here

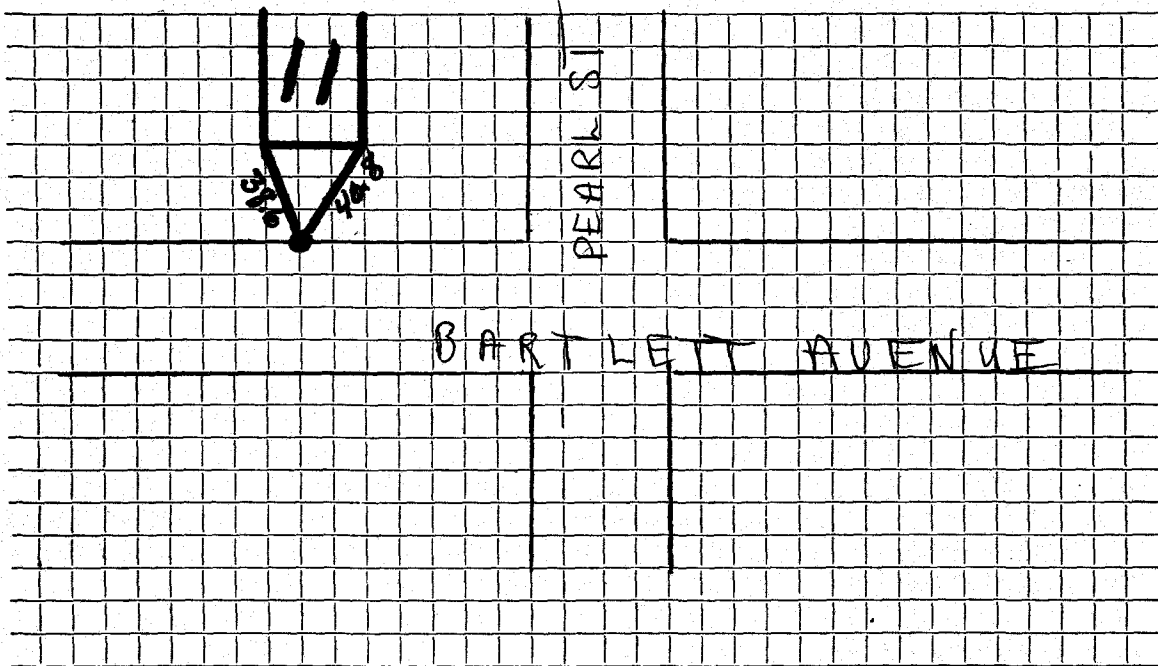

Connection made in ..... Street. Work completed .....

Remarks: .....  
.....  
.....