




DATE \_\_\_\_\_

# TOWN OF LEXINGTON — BOARD OF PUBLIC WORKS

## WATER DIVISION

Sketch of Service Here

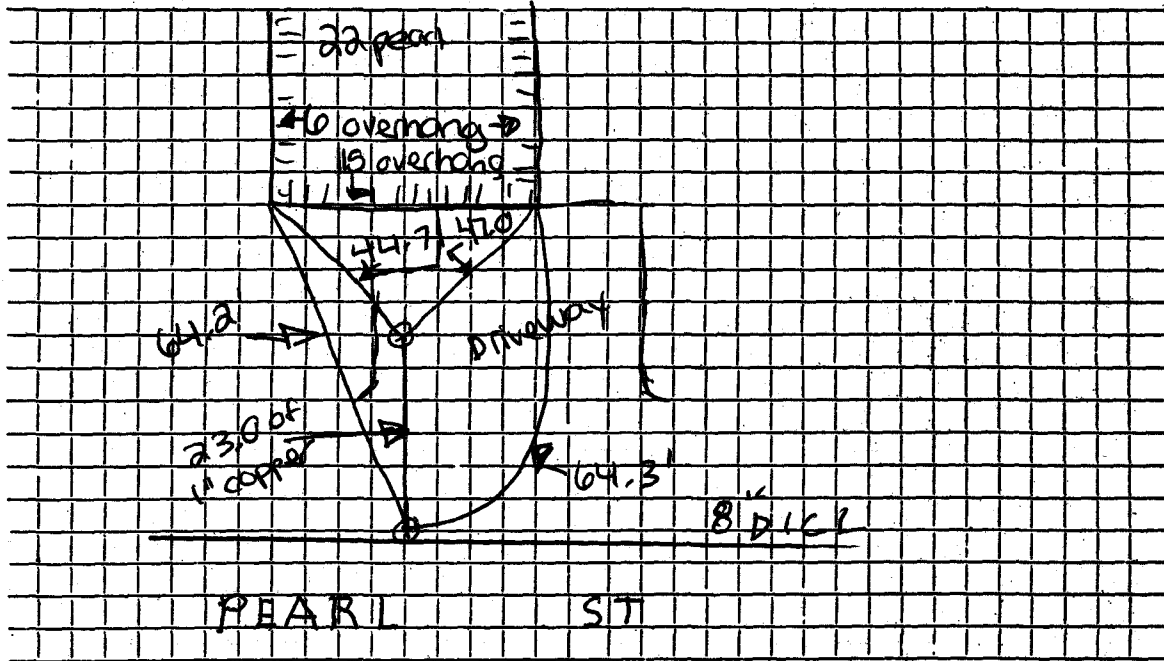

Connection made in ..... Street. Work completed 6/12/07 Def. l. i. c. e .....

Remarks: .....

.....

.....