


DATE _____

TOWN OF LEXINGTON — BOARD OF PUBLIC WORKS

WATER DIVISION

Sketch of Service Here

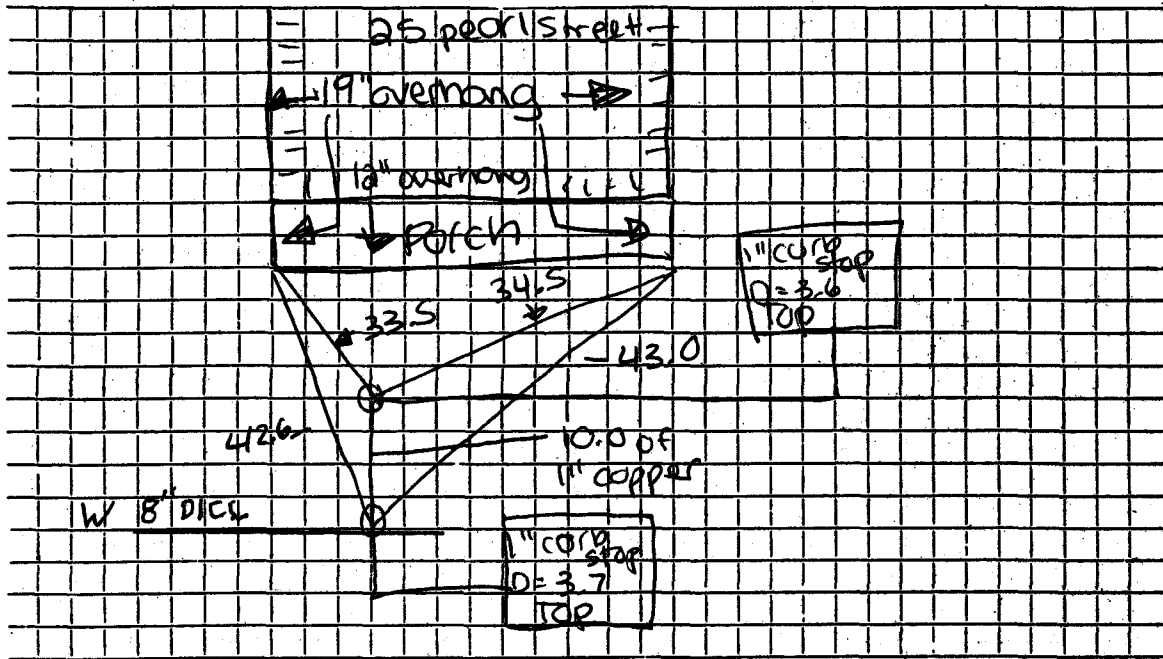

Connection made in Street. Work completed 6/12/07 D. F. Lize

Remarks: Existing curb & box left in place on property

2.5 }
29.6 }
old curb