


DATE _____

TOWN OF LEXINGTON — BOARD OF PUBLIC WORKS

WATER DIVISION

Sketch of Service Here

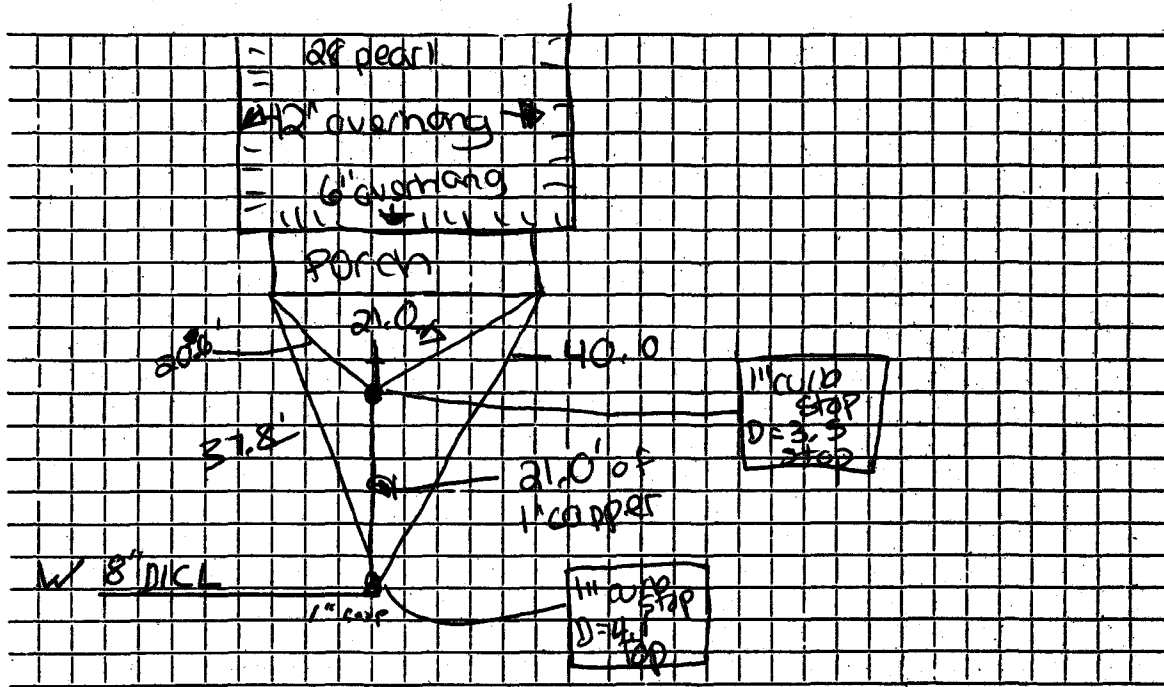

Connection made in _____ Street. Work completed 6/17/07 Defls <

Remarks: Old 3/4" Curb STOP left in Place w/box Tie # 28

