


DATE _____

TOWN OF LEXINGTON — BOARD OF PUBLIC WORKS

WATER DIVISION

Sketch of Service Here

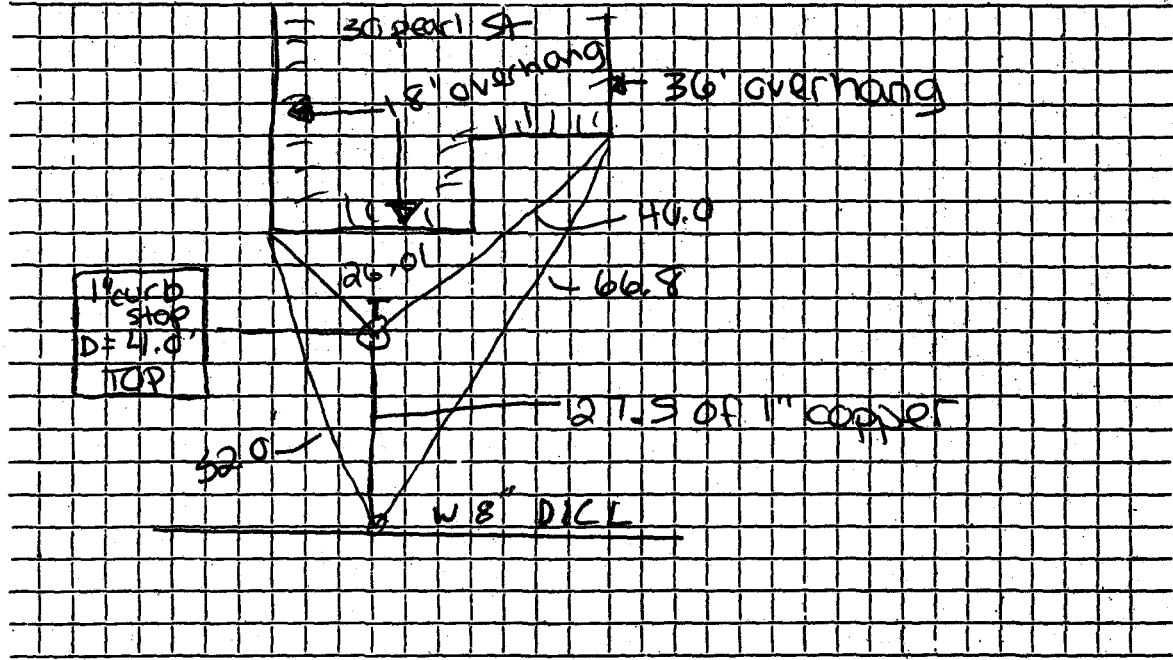

Connection made in Street.

Work completed 6/17/07, Def. 1.44.....

Remarks:
.....
.....