


Date: \_\_\_\_\_

TOWN OF LEXINGTON - BOARD OF PUBLIC WORKS  
WATER DIVISION

SKETCH OF SERVICE HERE

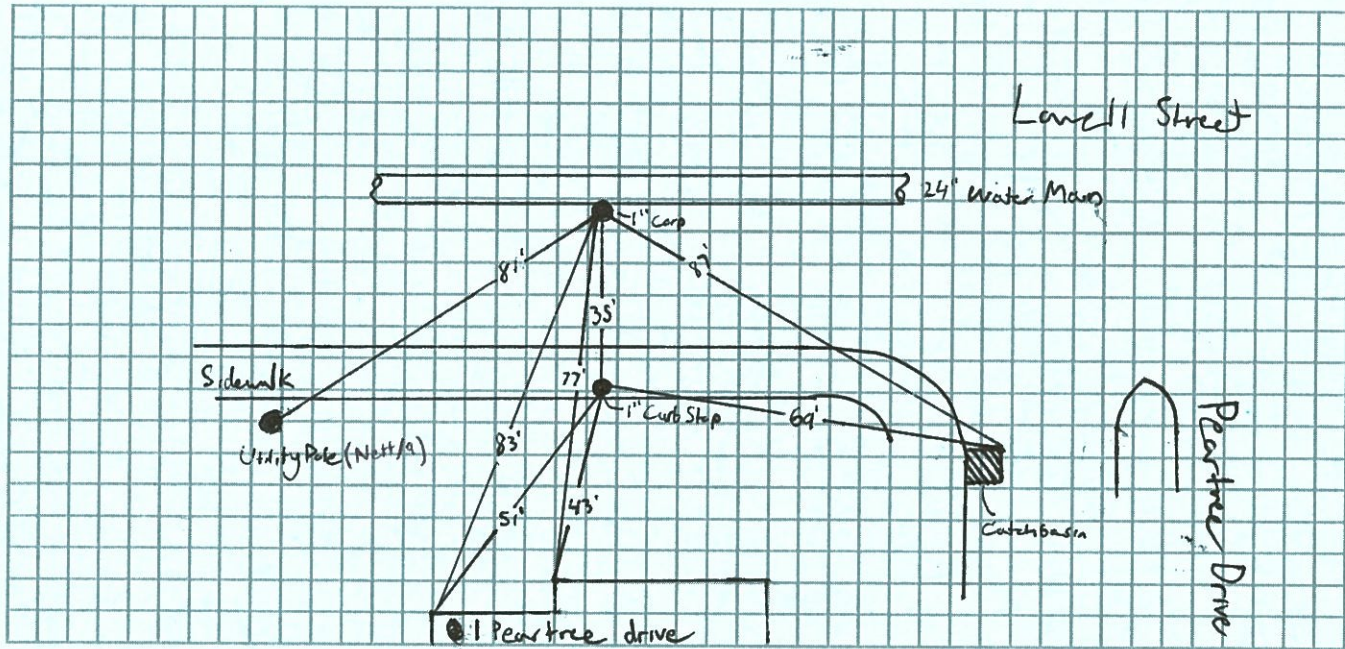

Connection made in: Lowell Street

Street.

Work completed:

Remarks:  
.....  
.....  
