


Date: _____

TOWN OF LEXINGTON - BOARD OF PUBLIC WORKS
WATER DIVISION

SKETCH OF SERVICE HERE

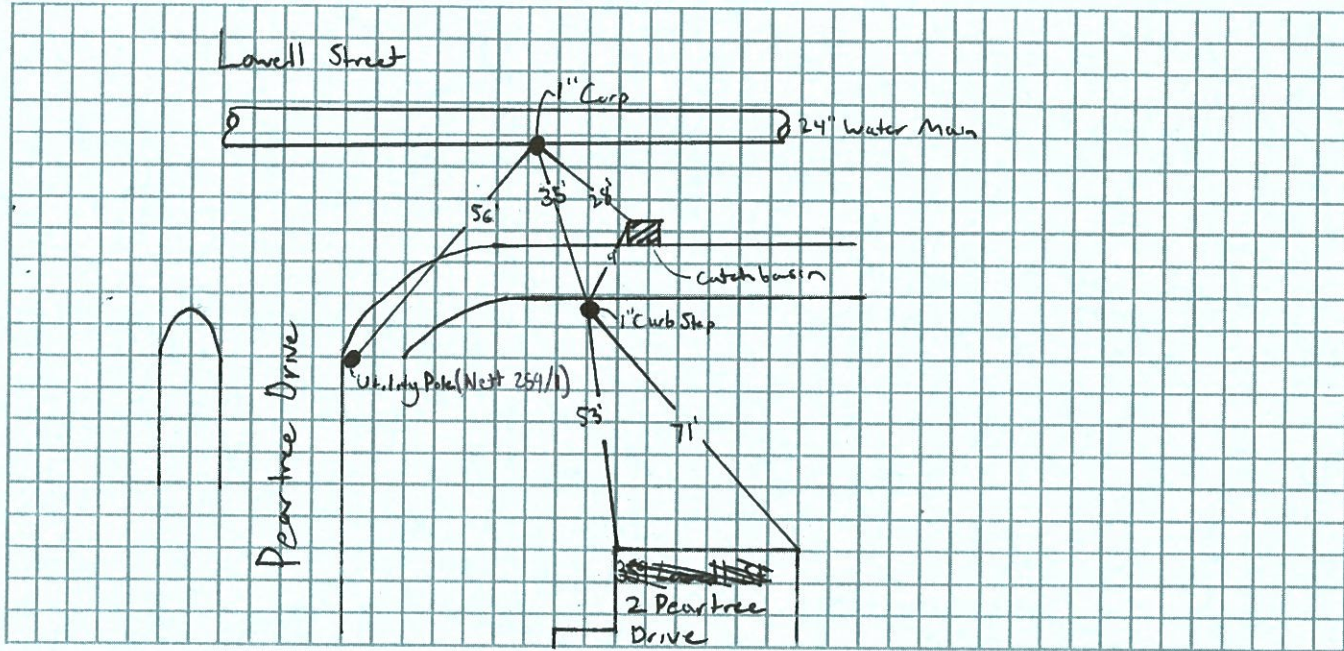

Connection made in: Lowell Street Street. Work completed: _____

Remarks: _____

