

WATER SERVICE RECORD

Name Kelly Corp.

Service No. 267

Address 3 Peartree Drive

Location Lexington

~~Repair~~ Renewal - New Service

Com. 12-1-52


Date	Material	Amount	Total	Date	Amount
10/28/52	Labor	1 63		10-9-52 Deposited	10 -
	10% overhead	16	1 79	12-1-52 Refunded	(3) 46
	1 -3/4"C x 1/2 I.W.H.stop& waste	4 00		NON CHARGE	1 54
	1 hr. trucking		75	10/28/52 Labor	3 83
			6 54	24' - 3/4" copper tubing@.34	8 16
	TRENCH DUG BY OWNER			1 -3/4"C. corp-cock	4 33
	PIPE SUPPLIED AND LAID BY OWNER			1 -3/4"C x 3/4"C. curb-cock	4 67
				1 box and rod	3 90
				1 1/2 straight tail pe.	50
				1 1/2 offset tail pe.	50
2-16-99	90'-1" Copper			1 hr. trucking	75
				10-29-57 Repair by Contractor	26 64
				5' 3/4" Copper	
				1 3/4"C. Curb Cock	
				2 3/4" Style 88 Couplings	

DATE _____

TOWN OF LEXINGTON — BOARD OF PUBLIC WORKS

WATER DIVISION

Sketch of Service Here

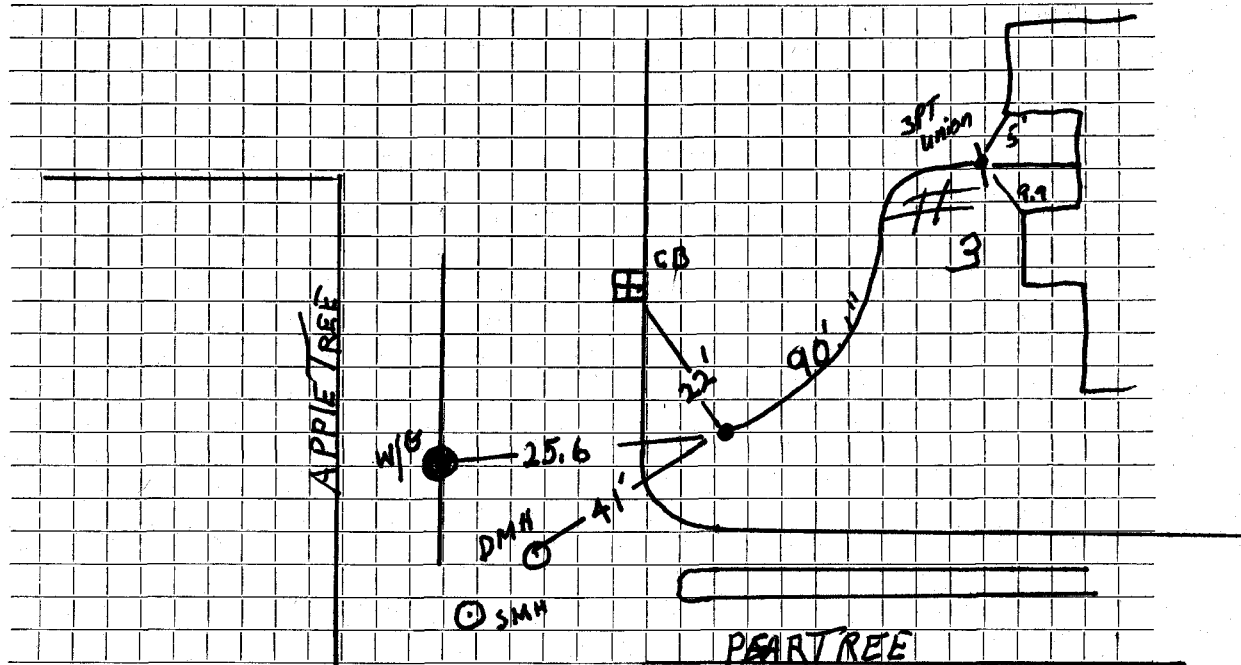

Connection made in Street.

Work completed

Remarks: Loc. W/Curb 11/12/98