


TOWN OF LEXINGTON — BOARD OF PUBLIC WORKS

WATER DIVISION

Sketch of Service Here

TIE 66/9A

6" ON
PELHAM RD
IS DEAD
G.T. AT MASS.

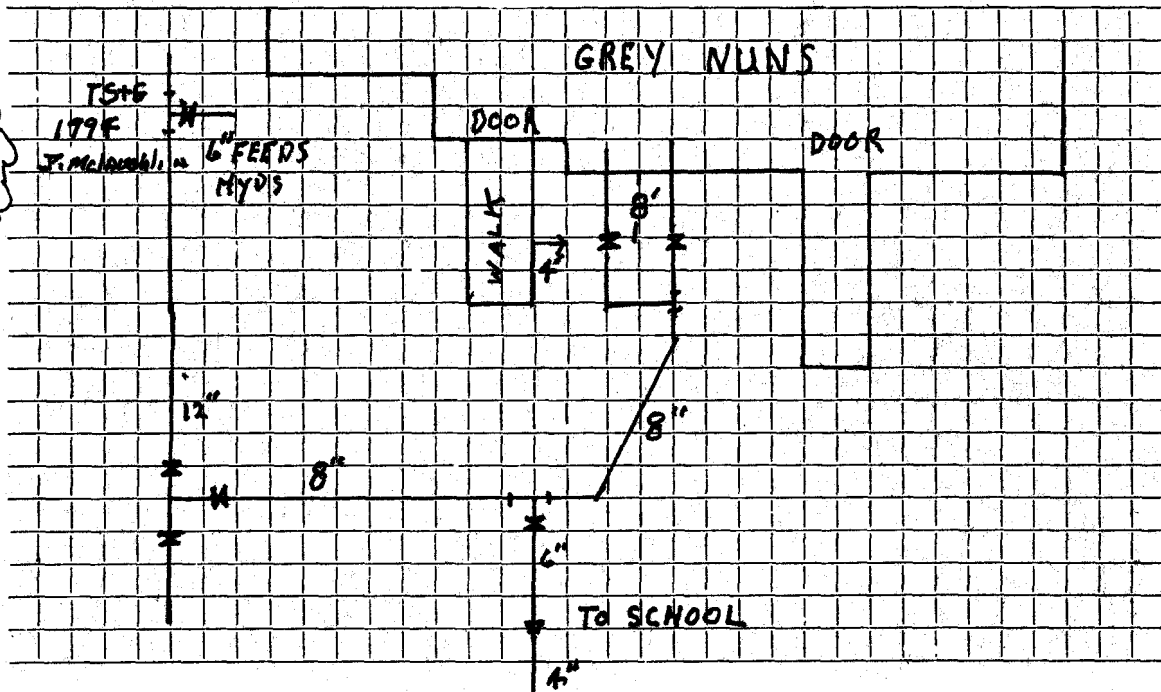

Connection made in Street. Work completed

Remarks:

.....
.....