


DATE 8/1/94

TOWN OF LEXINGTON — BOARD OF PUBLIC WORKS

WATER DIVISION

Sketch of Service Here

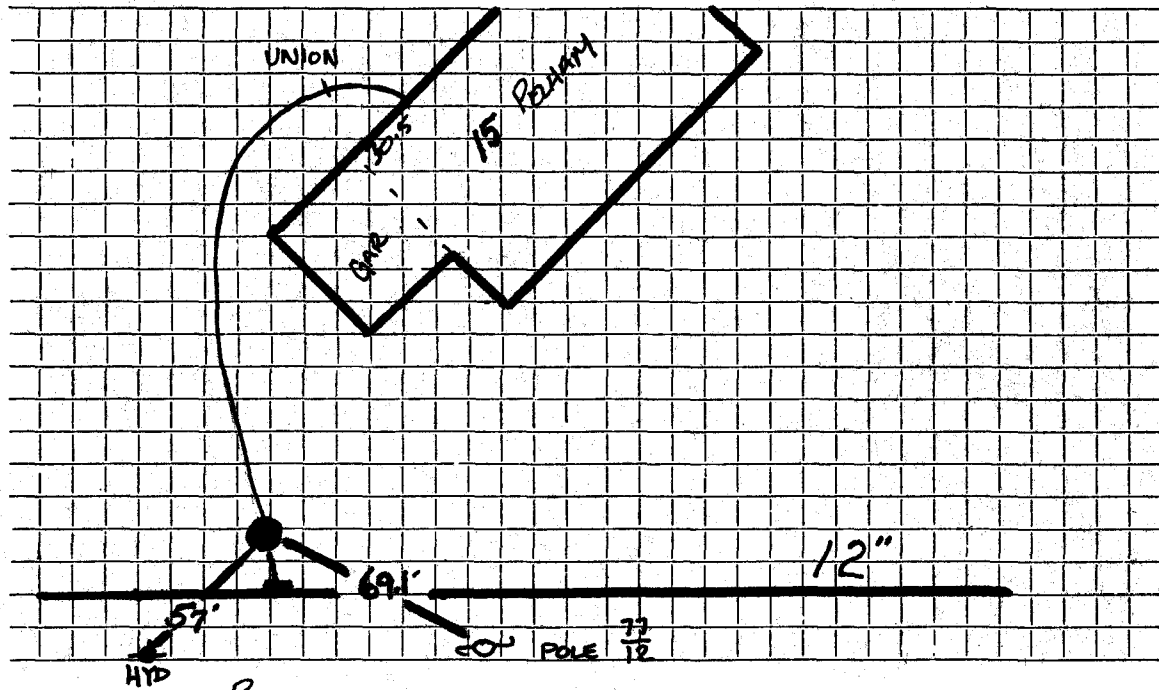

Connection made in PELHAM Street. Work completed

Remarks: