

## WATER SERVICE RECORD

Name Outhet Real ty Trust

Service No. 185

Address 1 Pelham Rd.

Location

~~REPAIR - RENEWAL~~ New Service


Comm 11-16-59

Date	Material	Amount	Total	Date	Amount
8-25-59	Labor	8 06		8-17-59	Deposit 75 00
	10% O. H.	81	8 87	11-16-59	Paid by WHC#217 1 99
105'	1" Copper tubing @.4676		49 10		76 99
1	1 x 1 I.W.H. Stop & Waste		6 63		NON CHARGE
1	1" C 3 part Union		3 80	8-25-59	Labor 8 06
1	1" x 3/4" Bushing		59	30'	1" Copper tubing @.4676 14 03
1	Hr. Town Shovel @6.50		6 50	1	1" C Corp Cock 6 92
2	Hrs. Trucking @.75		1 50	1	1" C Curb Cock 5 00
			76 99	1	Box & Rod 5 00
				1	3/4" Straight Tailpiece 50
				1	3/4" Offset Tailpiece 50
				1	Hr. Trucking @.75 75
					40 76

TOWN OF LEXINGTON — BOARD OF PUBLIC WORKS

WATER DIVISION

Sketch of Service Here

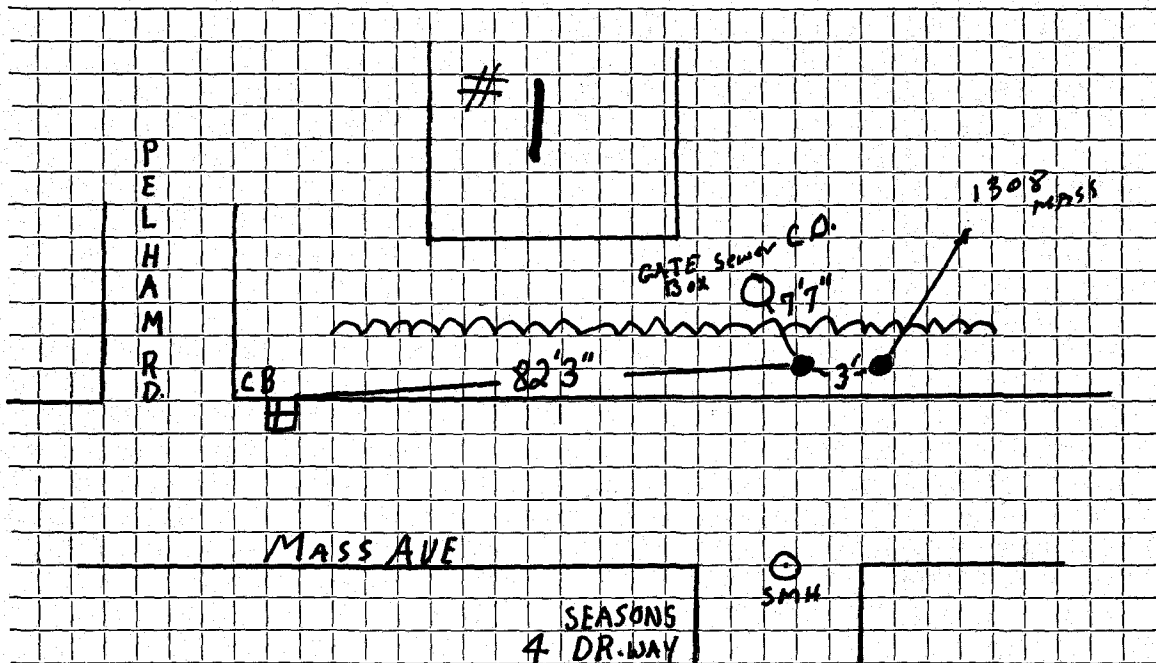

Connection made in ..... Street. Work completed .....

Remarks: .....

.....

.....