


DATE 8/2/19 e

TOWN OF LEXINGTON — BOARD OF PUBLIC WORKS

WATER DIVISION

Sketch of Service Here

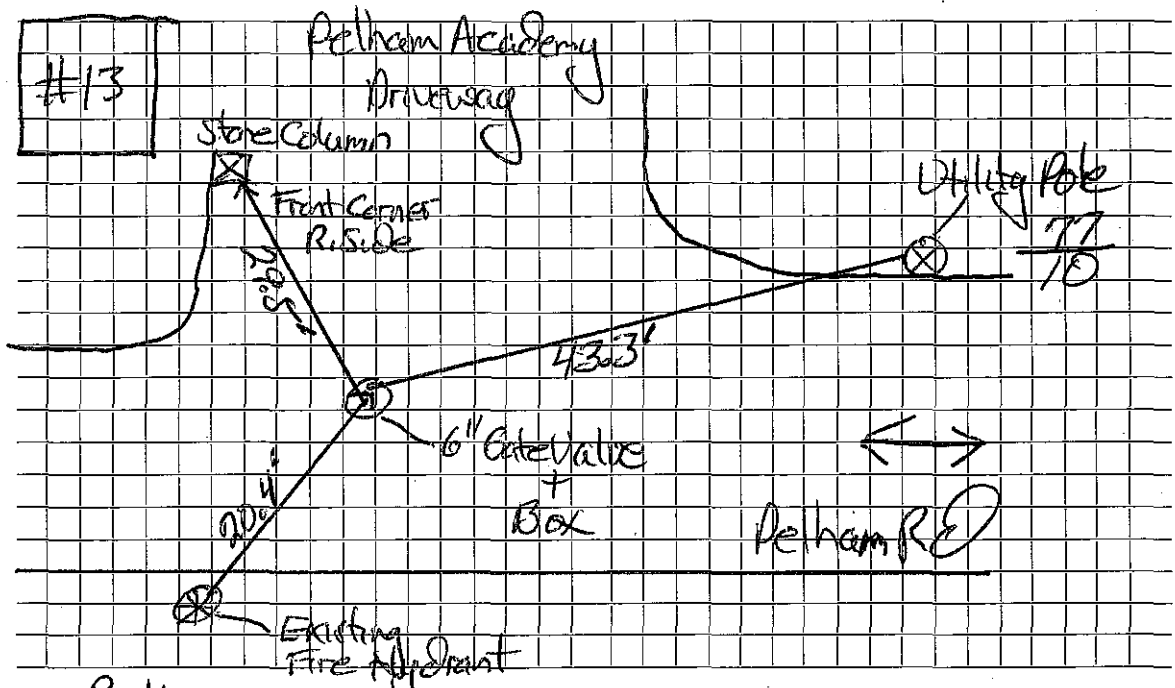

Connection made in Pelham Street. Work completed

Remarks: New 6" Gate Valve installed on Pelham Academy fire service

Repaired by Ventresca Inc. Materials by Town