

WATER SERVICE RECORD

Name The Grey Nuns Charities Inc.

Service No. 127

Address 13 Pelham Road (Bond House)

Location

~~Repair - Renewal~~ - New Service


Comm 9-19-60

Date	Material	Amount	Total	Date	Amount
8-2-60	Labor	82.63		7-18-60	Deposit 450.00
	10% O.H.	8.26	90.89	9-19-60	Retained 197.41
120'	1 1/2" Copper tubing @.74		88.80		252.59
1	1 1/2" Comp. Valve		11.30		NON CHARGE
3	1 1/2" 3 part unions @7.95		23.85	8-2-60	Labor 20.67
1	1 1/2" 2 part Male union		5.75	30'	1 1/2" Copper tubing @.74 22.20
4	hrs. Town Shovel @6.50		26.00	1	1 1/2" Corp Cock 23.97
2	hrs. Trucking @3.00		6.00	1	12 x 1 1/2 Saddle 15.94
			252.59	1	1 1/2" Curb Cock 27.74
				1	Buffalo Service Box 5.65
				1	hr. Town Shovel @6.50 6.50
					122.67

TOWN OF LEXINGTON — BOARD OF PUBLIC WORKS

WATER DIVISION

Sketch of Service Here

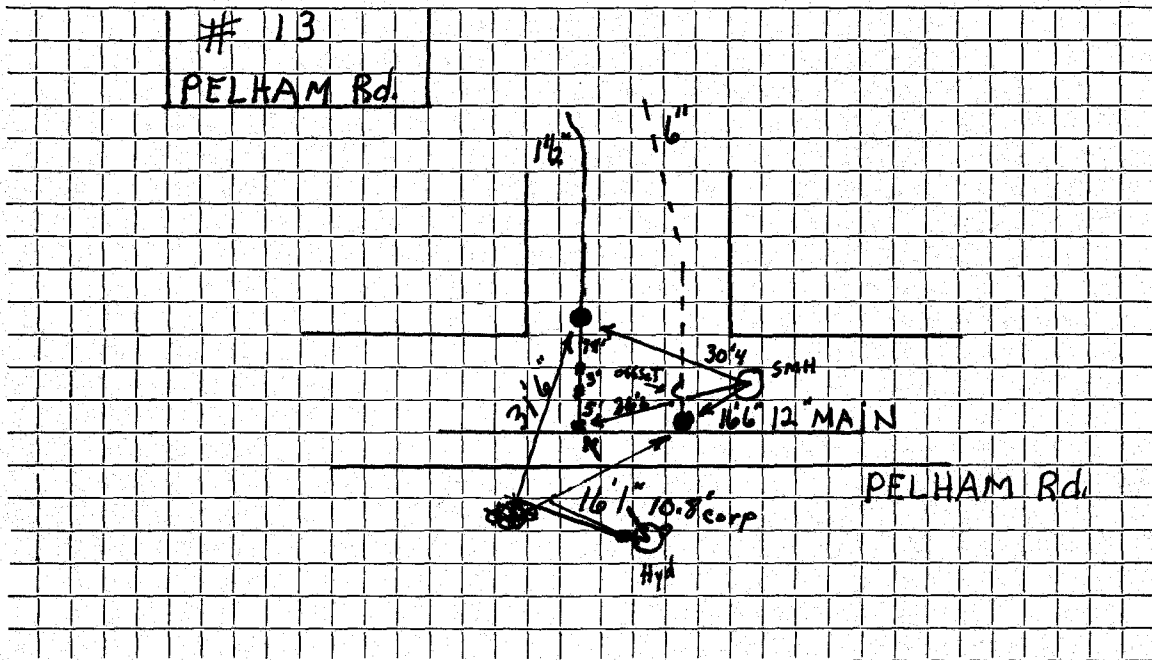

Connection made in Street. Work completed

Remarks; 2-Compression UNION'S 8-24-89 - 4' deep

6" Offset out of Gate