

Name Richard Engstrom

Service No. # 2196

Address 6 Eliot Road, Lexington, Mass.

GREY NUNS

Location Cottage - Pelham Road

Kind of Pipe

Size

Size of Main

~~Repair~~ Renewal

Location

of W. Rate book # 3952

Date 1942

Material Chargeable

Amount

Total

Date

Amount

May 7, 1942
from 7/1/42

32 hrs.	@ 55¢	17	60
219 "	@ 60¢	131	40
200 "	@ 65¢	130	00
9 "	@ 70¢	6	30
71½ "	@ 75¢	53	63
23 "	@ 1.00	23	00
10% Overhead			
503'	1" C.L. Pipe @ 25¢	125	75
23'	3/4" Copper tubing @ 21¢	4	83
1	3/4" C. Corp. cock	2	25
1	3/4" C. Curb cock	3	10
1	1" I x 3/4" I.W.H.S. & W.	2	25
1	3/4" Copper setter	3	00
26	1" L.L. Couplings @ 21¢	5	46
4	1" W.L. Elbows @ 30¢	1	20
2	1" Brass close nipples @ 10¢		60
1	3/4" C xl 1" Union		20
1	Pit cover & Frame	4	15
1	Box & Rod	1	65
500	Brick	8	00
6	bags cement @ 70¢	4	20
8	labor loads gravel @ 50¢	4	00
8.45	Tons Stone @ 2.00	16	90
19½	hrs. shovel @ 3.50	68	25
2	" compressor @ 2.25	4	50
6	" tractor @ 1.25	7	50
6	gas roller @ 1.50	9	00

April 11, 1942 Deprinted

700.00

361 93

36 19

125 75

CHARGE: \$700.00

Charges (cont'd) 675 61

34 hrs. trucking @ 75¢ 25 50

Trailer 18 00

Ledge, 10 cu.yds. @ 5.00 50 00

Total cost 769 11

Storage bill sent 5/11/42
Actual cost 769.11

Charged 700.00

Cost to Town 69.11

675 61

DATE April 11, 1942

TOWN OF LEXINGTON—BOARD OF PUBLIC WORKS
WATER DIVISION

The undersigned applies for a supply of water at No. 20 Pelham Road St. and hereby agrees to comply with the rules and regulations as now, or at any future time, established by the Board of Selectmen.

Am't. of Estimate \$ 700.00


Owner Richard Engstrom

Am't. Paid \$ _____

Address 6 Eliot Road

Builder _____

Sketch of Service Here

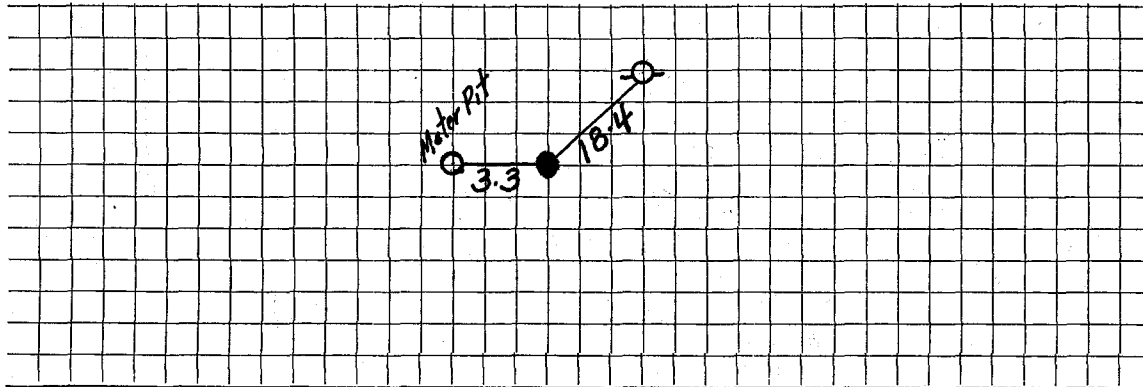

Connection made in _____ Street.

Work completed _____ 19

Remarks: