


DATE 9/10/19

TOWN OF LEXINGTON — BOARD OF PUBLIC WORKS

WATER DIVISION

Sketch of Service Here

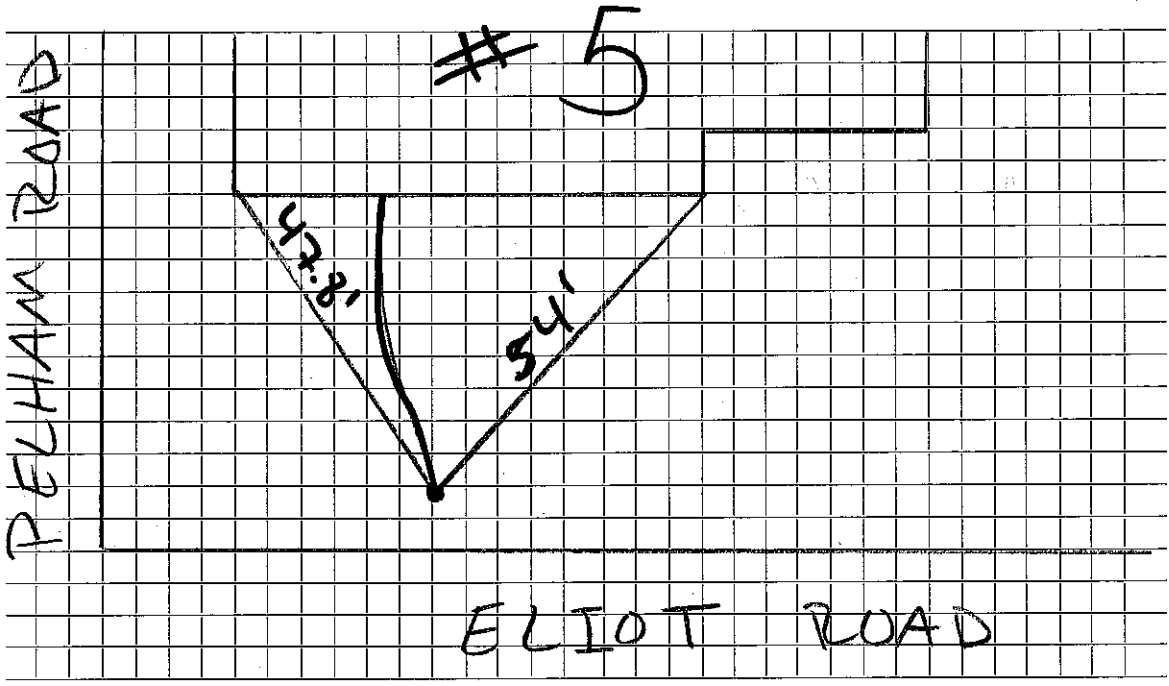

Connection made in Eliot Rd Street. Work completed

Remarks:

.....

.....