


TOWN OF LEXINGTON - BOARD OF PUBLIC WORKS
WATER DIVISION

Date: 11/2021

SKETCH OF SERVICE HERE

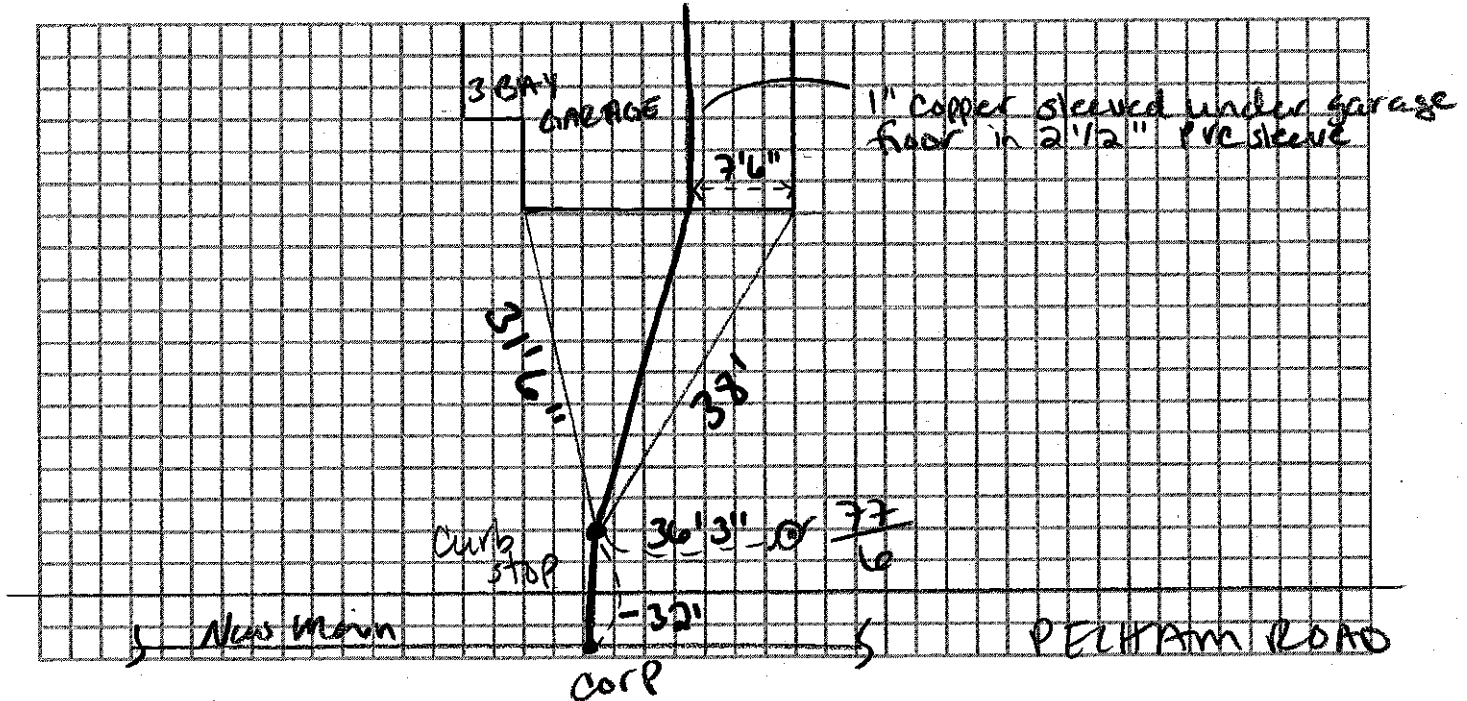

Connection made in: Pelham Rd

Street.

Work completed:

Remarks: