

WATER SERVICE RECORD

Name

Service No.

Address

11 Perry Rd. # 2594

Location

Repair—Renewal—New Service


Date	Material	Amount	Total	Date	Amount
4-10-47	118' 1" Copper				
	1 1" C. X $\frac{3}{4}$ " I.W.H. STop + Waste				
	2 1" C. X 1" C. - 3 Part Union			4-11-47	
				18' 1" Copper	
				1 1" C. Corp Cock	
				1 1" C. X 1" C. Curb Cock	
				1 Box + Rod	

DATE _____

TOWN OF LEXINGTON — BOARD OF PUBLIC WORKS

WATER DIVISION

Sketch of Service Here

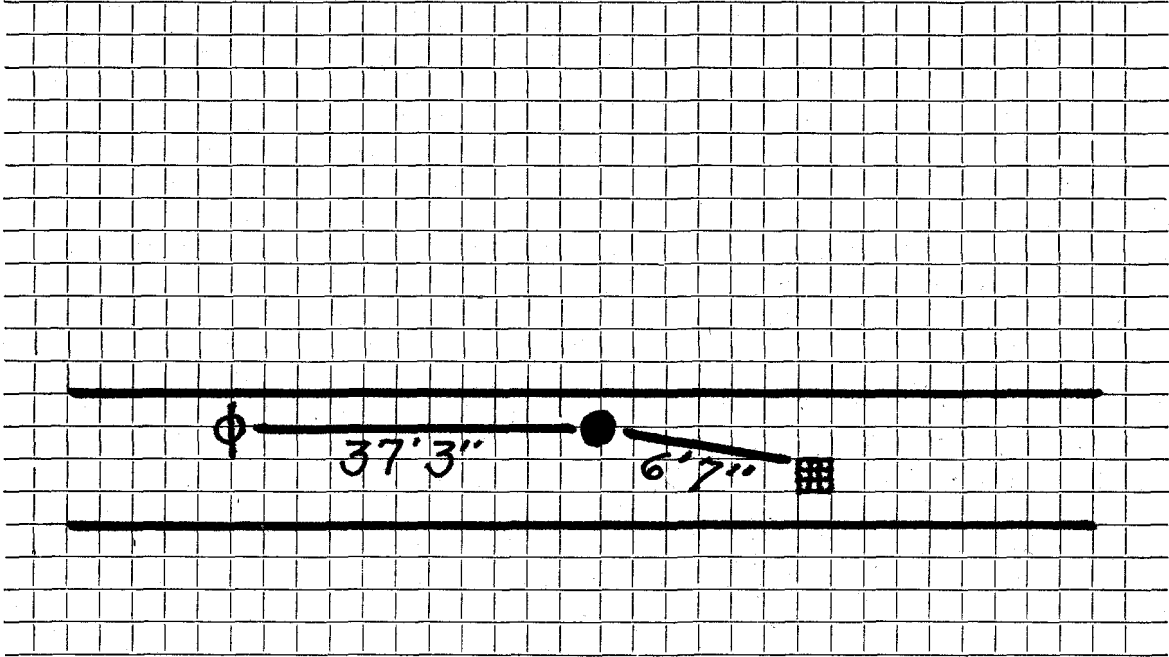

Connection made in Street. Work completed

Remarks:
.....
.....