

Name Paul R. Hederstedt

Service No. ~~77~~ 2200

Address 15 Percy Road, Lexington

# 7266

Location

Kind of Pipe

Size

Size of Main

Repair—Renewal—New Service

Location

Date	Material	Amount	Total	Date	Amount
Oct. 30, 1940	8 hrs. @ 60¢	4 80		October 18, 1940 Deposited	75 00
<i>Jan 17, 31-40</i>	10% Overhead	48	5 28	Dec 31, 1940 Refund.	14 45
	178' 3/4" Copper tubing @ 19¢		35 82		60 55
	1 3/4" C.S& W.		2 25		
	3 3/4" C.Unions @ 90¢		2 70		
	2 hrs. trucking @ 75¢		1 50		
	Trench Repairs		15 00		
			<u>\$60 55</u>		
	Labor				

Hadley Press, Inc., Lexington

DATE October 18, 1940

TOWN OF LEXINGTON—BOARD OF PUBLIC WORKS  
WATER DIVISION

The undersigned applies for a supply of water at No. 15 Percy St. and hereby agrees to comply with the rules and regulations as now, or at any future time, established by the Board of Selectmen.

Am't. of Estimate \$ 75.-

Owner

Paul P. Nedderstedt


Am't. Paid \$ 75.-

Address

15 Percy St  
Lexington

Builder \_\_\_\_\_

Sketch of Service Here

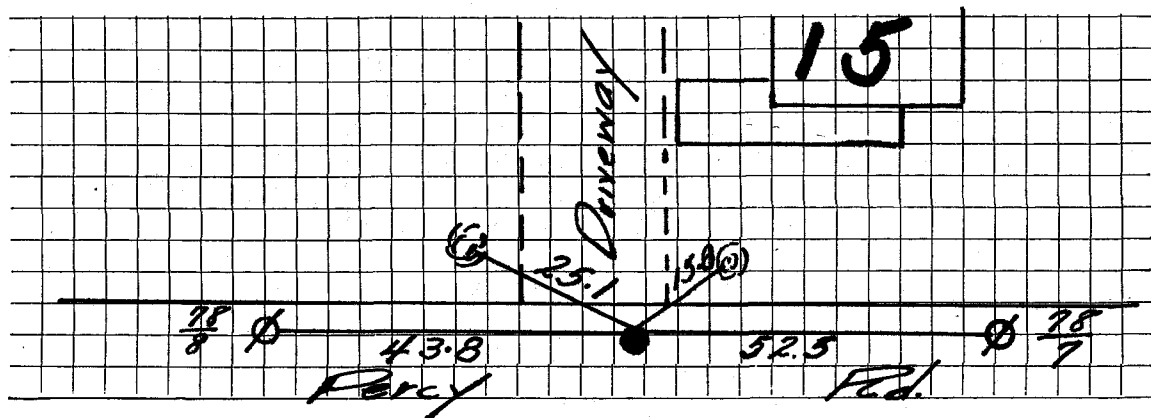

Connection made in \_\_\_\_\_ Street. Work completed \_\_\_\_\_ 19

Remarks: