

**WATER SERVICE RECORD**

Name **Philip F. Pullen**

Service No. **136**

Address **17 Percy Road**

Location

Repair—Renewal—~~New Service~~

*Comm 11-12-58*


Date	Material	Amount	Total	Date	Amount
6/19/58	Labor	75 40		7-15-58	150 00
	"	48 30		<del>11-26-58</del>	<del>29 78</del>
	10% overhead	12 17	133 87		179 78
	90'-3/4" copper tubing @.37		33 30		NON CHARGE
	1-3/4" C 3 part union		2 27	6/19/58 Labor	24 15
	1-3/4" Cx 1/2 I.W.H. stop & waste		5 84	1-1/2" straight tail piece	50
	2 hrs. trucking @.75		1 50		24 65
	1 hr. Hough shovel @ 3.00		3 00		
			<u>179 78</u>		

*Bill sent 11-12-58 29.78*

TOWN OF LEXINGTON — BOARD OF PUBLIC WORKS

WATER DIVISION

Sketch of Service Here

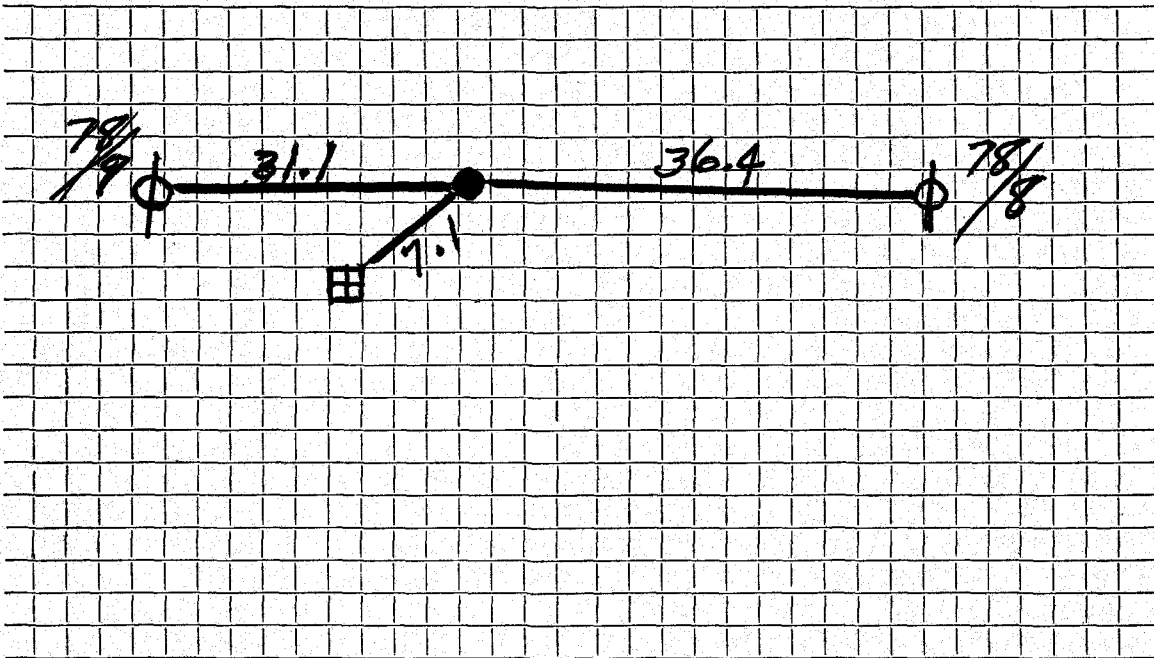

Connection made in ..... Street. Work completed .....

Remarks: .....  
.....  
.....