

Name

Service No. 2205

Address

across st. from House #20

Location

20 Percy Rd. (Garage)

Kind of Pipe

Size

Size of Main

Repair—Renewal—New Service

Location

Date

Material

Amount

Total

Date

Amount

NOT IN USE

JW 8-27-84

Labor

DATE _____

TOWN OF LEXINGTON—BOARD OF PUBLIC WORKS

WATER DIVISION

The undersigned applies for a supply of water at No. _____ St. and hereby agrees to comply with the rules and regulations as now, or at any future time, established by the Board of Selectmen.

Am't. of Estimate \$ _____

Owner

Mrs M E. Newell


Am't. Paid \$ _____

Address

20 Percy Rd
(Garage)

Builder _____

Sketch of Service Here

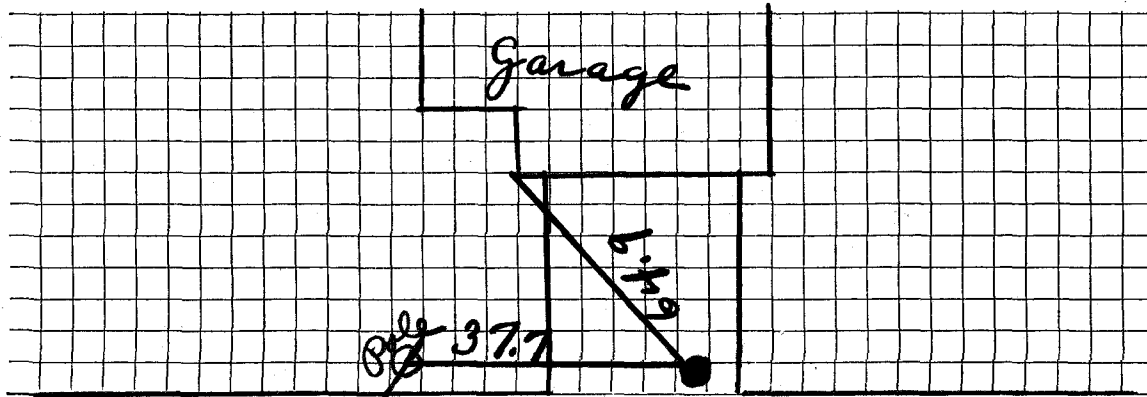

Connection made in Percy Street. Rd Work completed _____ 19


Remarks: This service no in use JW 8-27-84

DATE _____

TOWN OF LEXINGTON — BOARD OF PUBLIC WORKS

WATER DIVISION

Sketch of Service Here

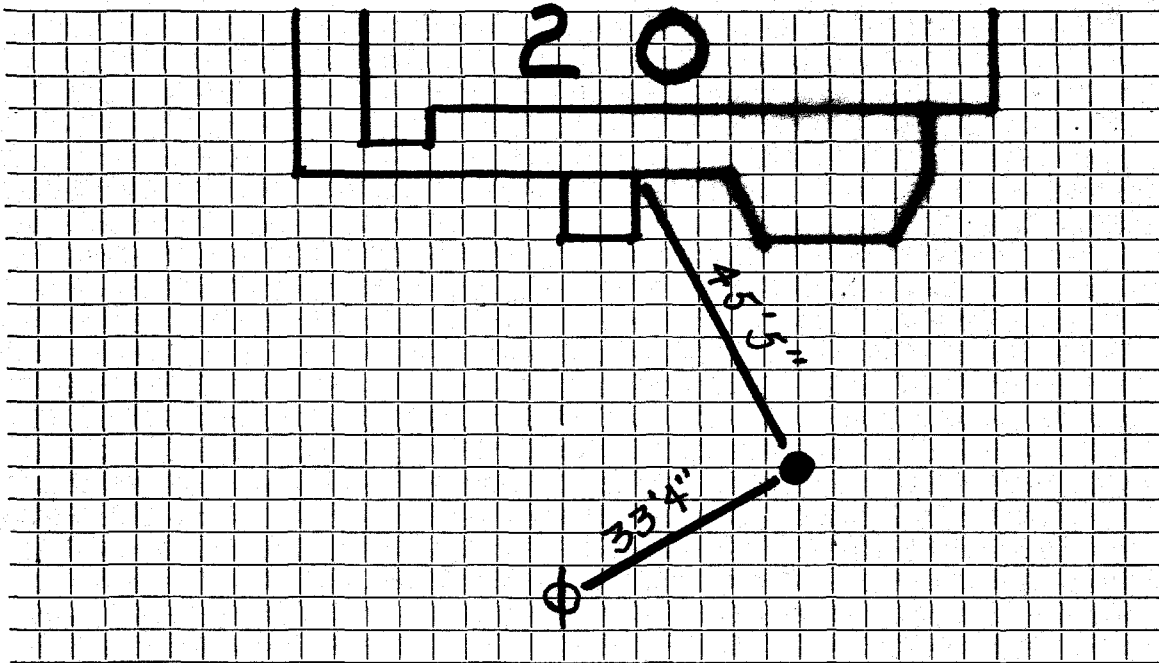

Connection made in Street. Work completed

Remarks:

.....

.....