

WATER SERVICE RECORD

Name Alton C. Dowling

Service No. 43

Address 27 Percy Road

Location

~~Renewal~~ Renewal—New Service W.O. #71

DEC 26 1978


Date	Material	Amount	Total	Date		Amount
11-16-78	Labor	114.30		11-13-78	Deposit	350.00
	10% O.H.	11.43	125.73	12-26-78	Retard	151.81
	30' 3/4" Copper tubing @.74		22.20			198.19
	1 3/4" Stop & Waste		17.10			
	1 3/4" x 1/2" Reducer		1.56			
	1 1/2" Tailpiece		1.00			
	2 yds. Loam @5.44		10.88			
	3 lbs. Seed @.74		2.22			
	1 1/2 hrs. Trucking @3.00		4.50			
	2 hrs. Backhoe		13.00			
			198.19			

DATE _____

TOWN OF LEXINGTON — BOARD OF PUBLIC WORKS

WATER DIVISION

Sketch of Service Here

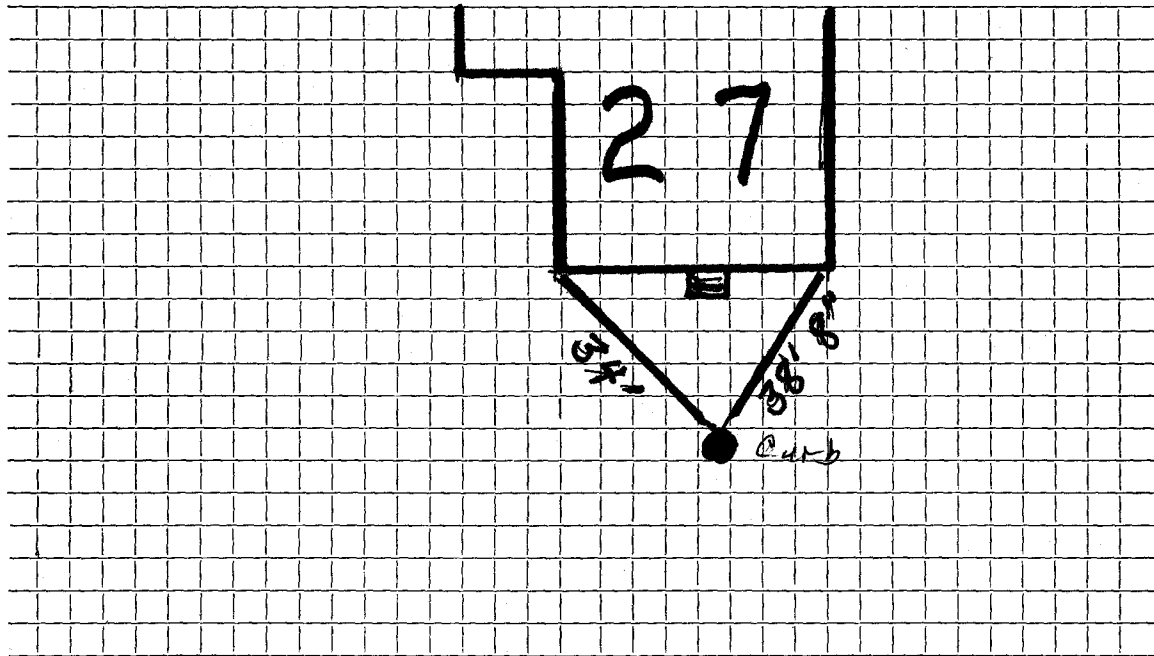

Connection made in Street. Work completed

Remarks:

.....

.....