

WATER SERVICE RECORD

Name **Charles L. Whipple**

Service No. **168**

Address **28 Percy Road**

7782

Location

~~Repair~~ ~~Renewal~~ ~~New~~ ~~Service~~

Comm **12-1-58**


Date	Material	Amount	Total	Date	Amount
8/12/58	labor	62 31		8-6-58	Deposit 230 00
	10% overhead	6 23		12-1-58	Refund 55 51
			68 54		164 19
	140' 3/4" copper tubing @ .37	51 80			
	3 3/4" 3 part Union @ 2.27	6 81			NON CHARGE
	1 3/4" Cx3/4" IWH stop & waste			8/14/58	labor 47 93
			5 84		1 hr trucking @ .75 75
	3 hrs. town shovel @ 6.50	19 50			1 hr town shovel @ 6.50 6 50
	2 hrs. trucking @ .75		1 50		7 25
	2 hrs. Trojan Loader @ 3.00	6 00			
	3 bags rock wool @ 1.40	4 20			
			164 19		

DATE _____

TOWN OF LEXINGTON — BOARD OF PUBLIC WORKS

WATER DIVISION

Sketch of Service Here

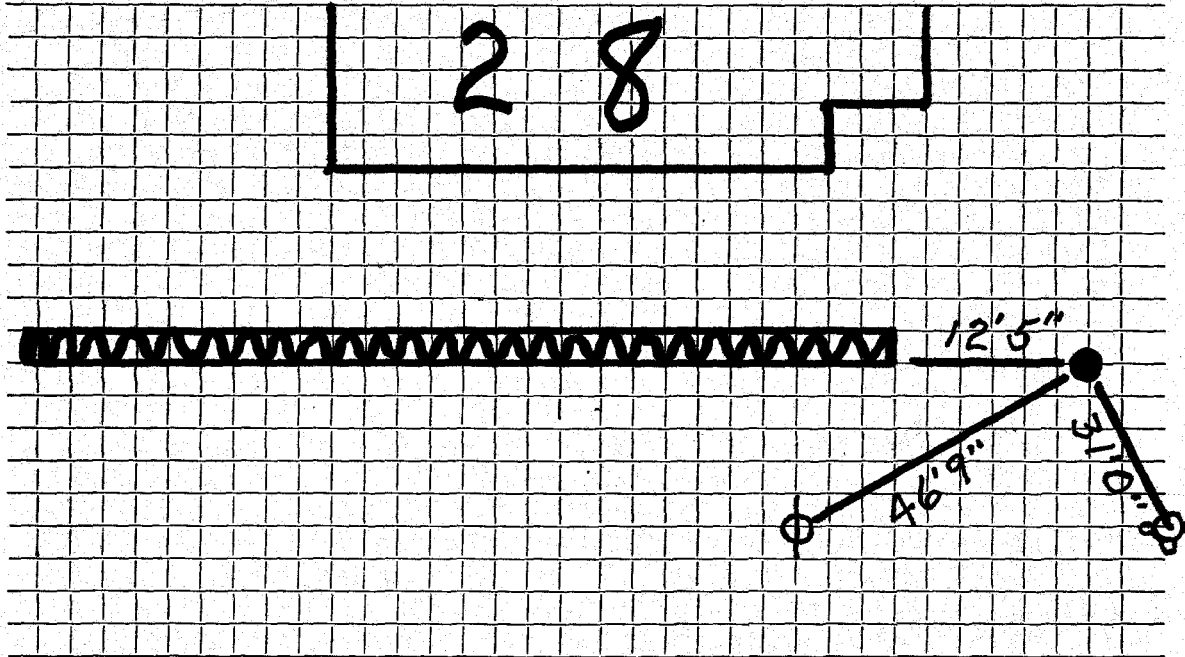

Connection made in Street. Work completed

Remarks:

.....

.....