




DATE 9/20/90

TOWN OF LEXINGTON — BOARD OF PUBLIC WORKS  
**WATER DIVISION**

Sketch of Service Here

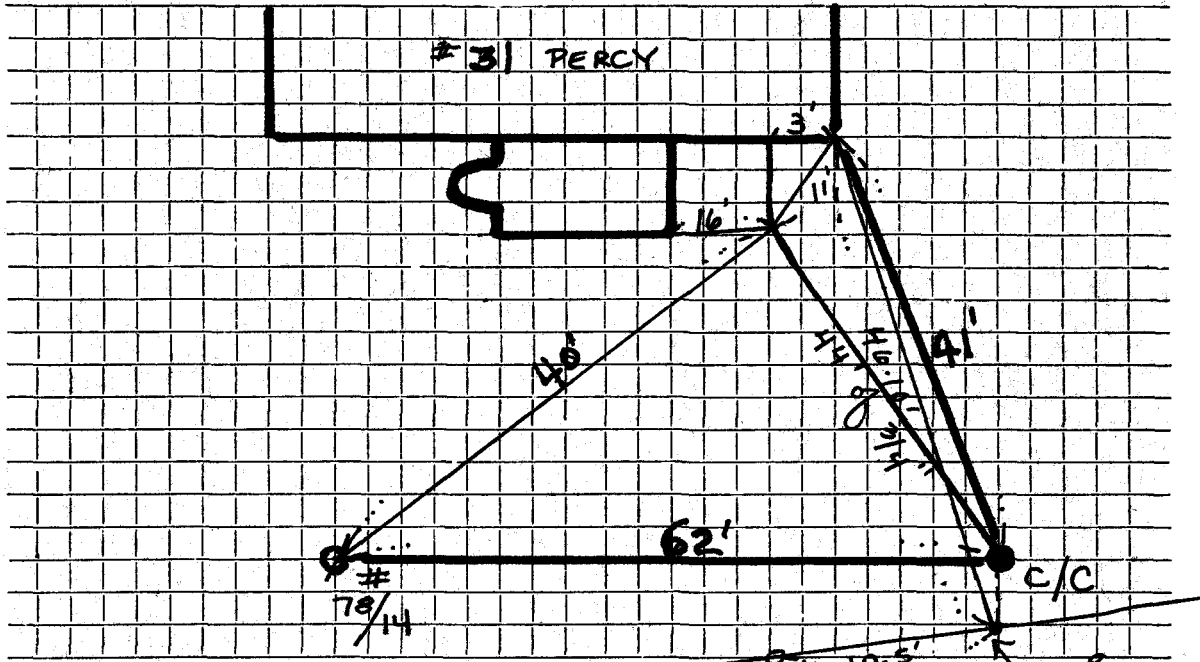

Connection made in ..... PERCY ..... Rd. Street. Work completed ..... 10.5' GAS GATE CORP. CORP. .....

Remarks: ... CONTRACTOR: ARLEX .....

..... INSPECTOR: P. BARRONS .....

.....