

Name H. C. Titus

Service No. ~~00~~ 2210

Address 32 Percy Road, Lexington

3288

3289

Location

Kind of Pipe

Size

Size of Main

~~Repair~~ ¹ Renewal — ~~New Service~~ ²

Location

Date
1941

Material

Amount

Total

Date

Amount

July 7,
Sum 8/24/41

24 hrs @ 50¢ 12 00

2 " @ 60¢ 1 20

2 " @ 70¢ 1 40

10 % Overhead 1 46

58' 1" Copper tubing @ 22¢ 12 76

1 1" C. S. & W. 2 50

1 1" x 3/4" Bushing 30

1 1" C x 1" I. Union 70

1 hr. trucking 75

\$33 07

June 30, 1941 Deposited
August 20, 1941 Refunded

45 00

11 93

33 07

Labor

Hadley Press, Inc., Lexington

DATE _____

TOWN OF LEXINGTON—BOARD OF PUBLIC WORKS

WATER DIVISION

The undersigned applies for a supply of water at No. _____ St. and hereby agrees to comply with the rules and regulations as now, or at any future time, established by the Board of Selectmen.

Am't. of Estimate \$ _____


Owner _____

Am't. Paid \$ _____

Address _____

Builder _____

Sketch of Service Here

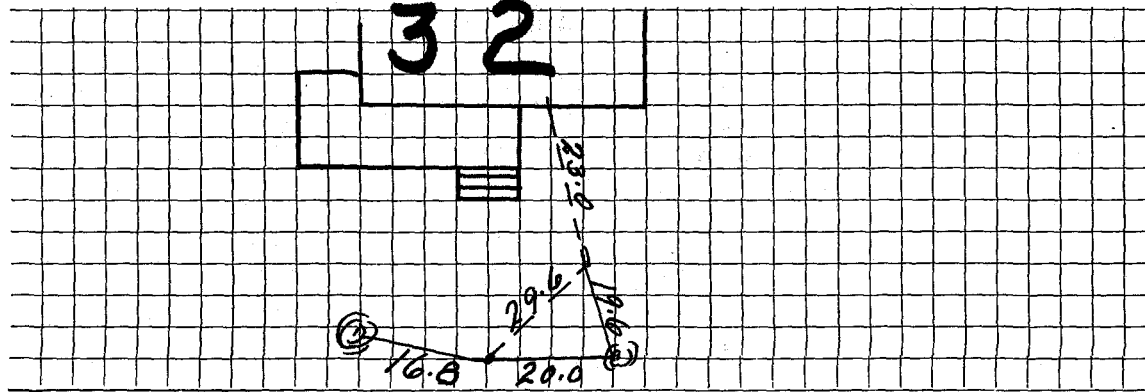

Connection made in _____ Street.

Work completed _____ 19

Remarks: