

WATER SERVICE RECORD

Name Dr. William Way

Service No. 14

Address 36 Percy Road

Location

~~Repair~~ - Renewal - ~~NEW SERVICE~~

Com. 3-21-55


Date	Material	Amount	Total	Date	Amount
1/14/55	Labor	23 00		1-19-55	Deposited 45 00
	10% overhead	2 30	25 30	3-21-55	Refunded 6 00
	41' - 3/4" copper tubing @ .35		14 35		42 40
	1 - 3/4" C x 1/2 I.W.H. stop & waste		4 00		
	1 hr. trucking		75		
			<u>44 40</u>		

DATE _____

TOWN OF LEXINGTON — BOARD OF PUBLIC WORKS

WATER DIVISION

Sketch of Service Here

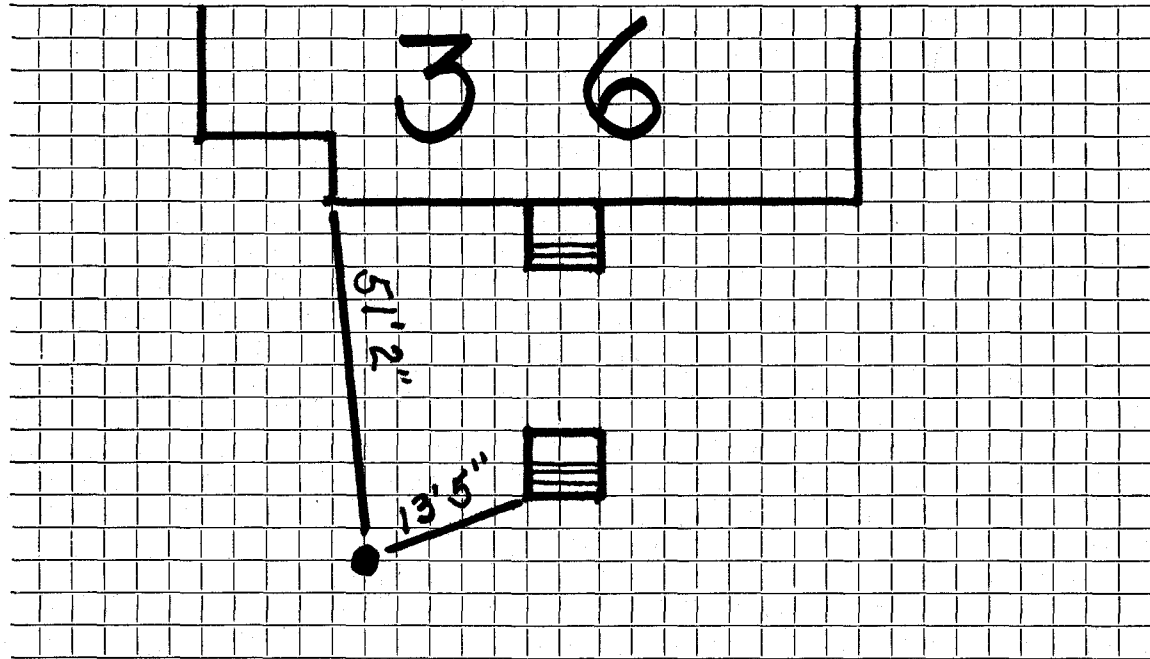

Connection made in Street. Work completed

Remarks: *Original Service* ... *8-27-27*

.....
.....