

Name **James Smith**Service No. **26**Address **4 Percy Road****Lexington, Mass.**Location **4 Percy Road**Kind of Pipe **Com. 3-7-49**

Size

Size of Main

~~REPAIR~~ - Renewal - ~~NEW SERVICE~~

Location

Date	Material	Amount	Total	Date	Location	Amount
Jan. 11, '49	<i>house to curb</i> Labor	45 00	45 00	Jan 15 '49	<i>Cast</i>	68 90
	10% Overhead		4 50		<i>curb to main</i>	
	50' - 1" Copper Tubing		15 50		Non-Charge	
	1 - 1" C X 3/4" I.W.H. S&W		3 15	Jan. 11, '49	Labor	21 00
	Trucking 1 hr. @ .75		75		10' - 1" Copper Tubing	3 10
			68 90		1 - 1" C Corp-cock	4 62
					1 - 1" C x 1" C Curb-cock	4 80
	<i>Bill sent 3-7-49</i>				1 - Box & Rod	3 55
					1 - 3/4" Straight Tail Piece	30
					Compressor # 36 2 hrs.	5 50
					Trucking 1 hr. @ .75	75
					Patching 5 x 3	5 00
	Labor					48 62

DATE _____

TOWN OF LEXINGTON - BOARD OF PUBLIC WORKS

WATER DIVISION

The undersigned applies for a supply of water at No..... St. and hereby agrees to comply with the rules and regulations as now, or at any future time, established by the Board of Selectmen.

Am't of Estimate \$.....

Owner


Am't Paid \$.....

Address

Builder

.....

Sketch of Service Here

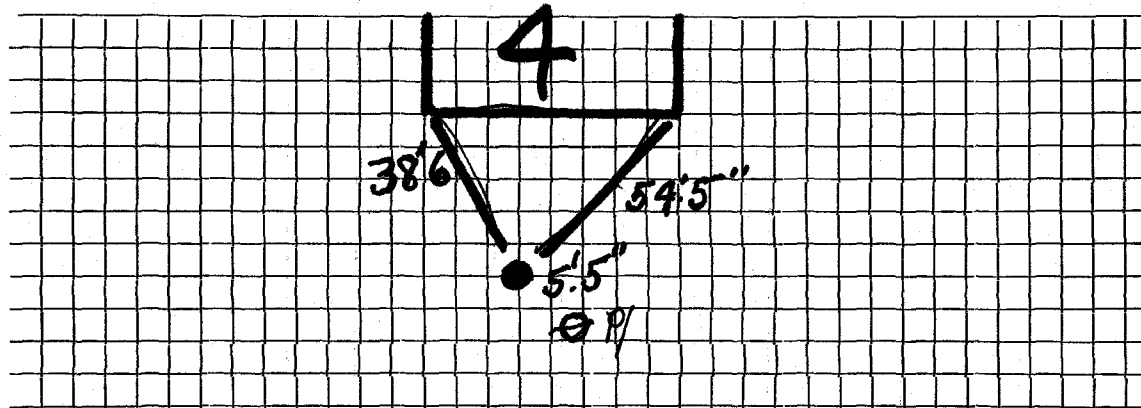

Connection made in Street.

Work completed19

Remarks: