


TOWN OF LEXINGTON — BOARD OF PUBLIC WORKS
WATER DIVISION

Sketch of Service Here

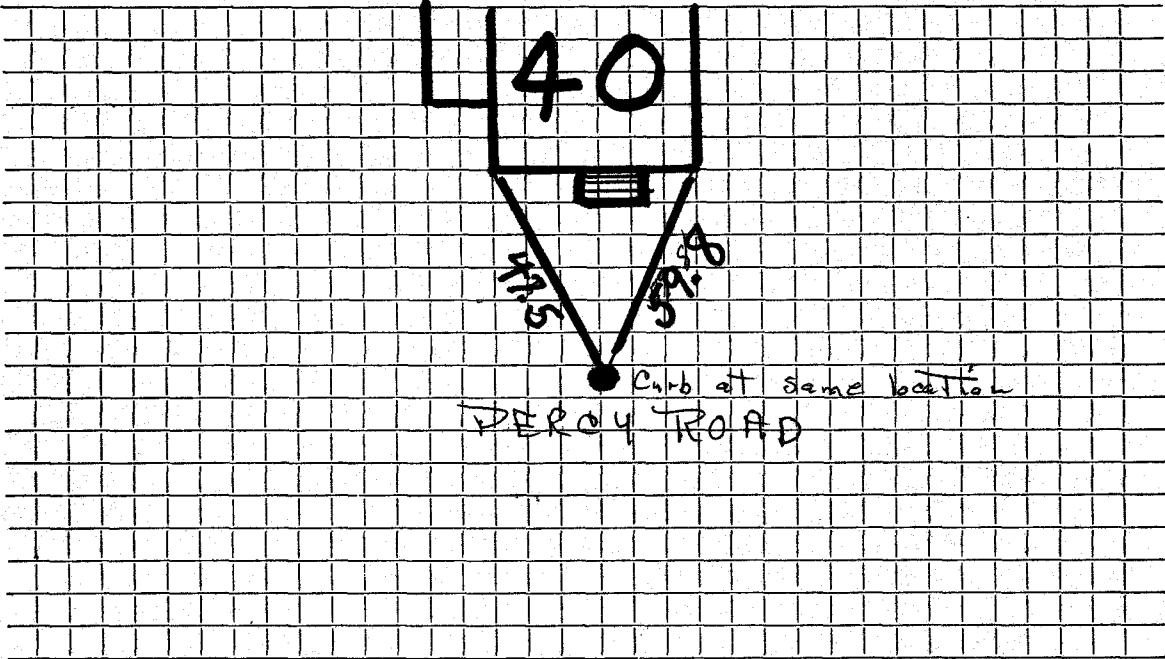

Connection made in Street. Work completed

Remarks: Same... Tie... as... before... -... service... installed... so... far... back... there... was...
... no... date... on... card...
.....
.....