

Name ~~PHILIP NEWBOLD~~ PHILIP NEWBOLD

Service No. ~~00~~ 2214

Address 167 Hillside Ave., Arlington

Location 41 Percy Road

Kind of Pipe Size Size of Main

Repair—Renewal—New Service

Location

Date	Material	Amount	Total	Date	Amount
1941					
September 3,	2 hrs. @ 60¢	1 20		August 5, 1941 Deposited	24 00
Com 10/13/41	10% Overhead	12	1 32	Oct 21, 1941 Refund	9 13
	45' 3/4" Copper tubing @ 19¢		8 55		14 87
	1 3/4" S. & W.		2 50		
	1 3/4" C. Union (3 part)		1 00		
	Trucking, 2 hrs. @ 75¢		1 50		
12-27-71	Repair		14 87		
	1 3/4" Repair Clamp				
	Labor				

Hadley Press, Inc., Lexington

DATE July 29, 1941

TOWN OF LEXINGTON—BOARD OF PUBLIC WORKS

WATER DIVISION

The undersigned applies for a supply of water at No. 41 Percy Road St. and hereby agrees to comply with the rules and regulations as now, or at any future time, established by the Board of Selectmen.

Am't. of Estimate \$ 24 - ~~_____~~

Owner Carolyn D Ide


Am't. Paid \$ _____

Address 167 Hillside -

Builder William A. Pride Map 2830

Arlington

Sketch of Service Here

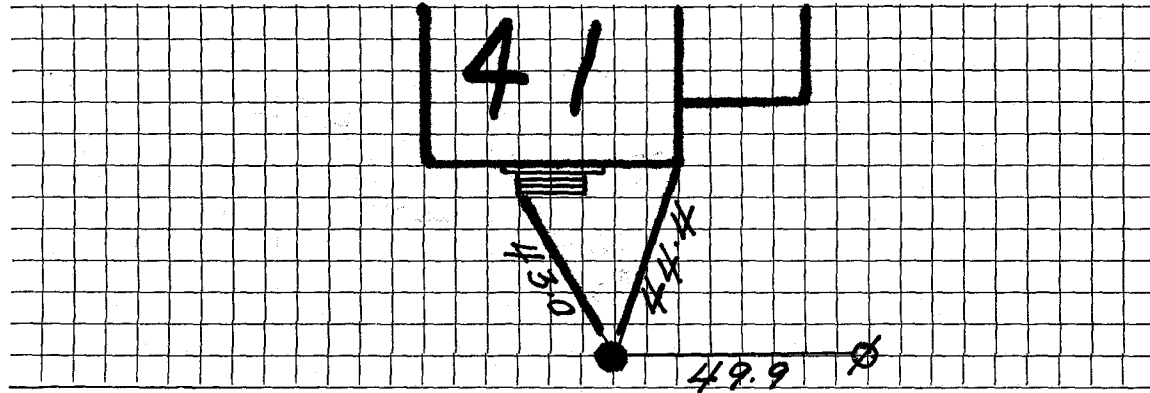

Connection made in _____ Street.

Work completed _____ 19

Remarks: