

WATER SERVICE RECORD

Name Rafael Bras

Service No.

Address 44 Percy Road

Location

Repair—~~Removed New Service~~ Dave Eagle #3695

Date		Material	Amount	Total	Date	Amount
5/4/82	53'	3/4" Copper tubing				


OUTSIDE

3/4" Copper tubing

DATE _____

TOWN OF LEXINGTON — BOARD OF PUBLIC WORKS
WATER DIVISION

Sketch of Service Here

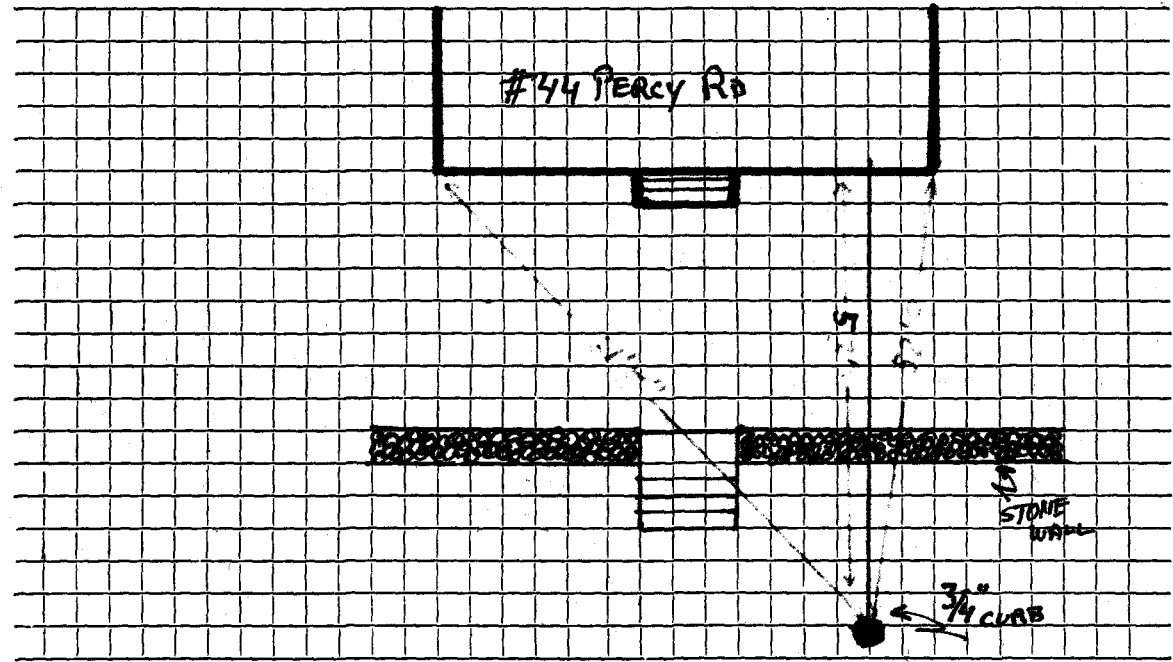

Connection made in Street. Work completed

Remarks:
.....
.....