
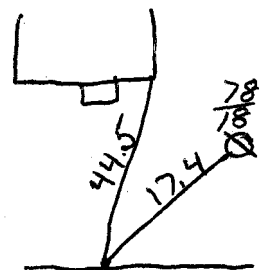


DATE 9-23-94

TOWN OF LEXINGTON — BOARD OF PUBLIC WORKS

WATER DIVISION

Sketch of Service Here

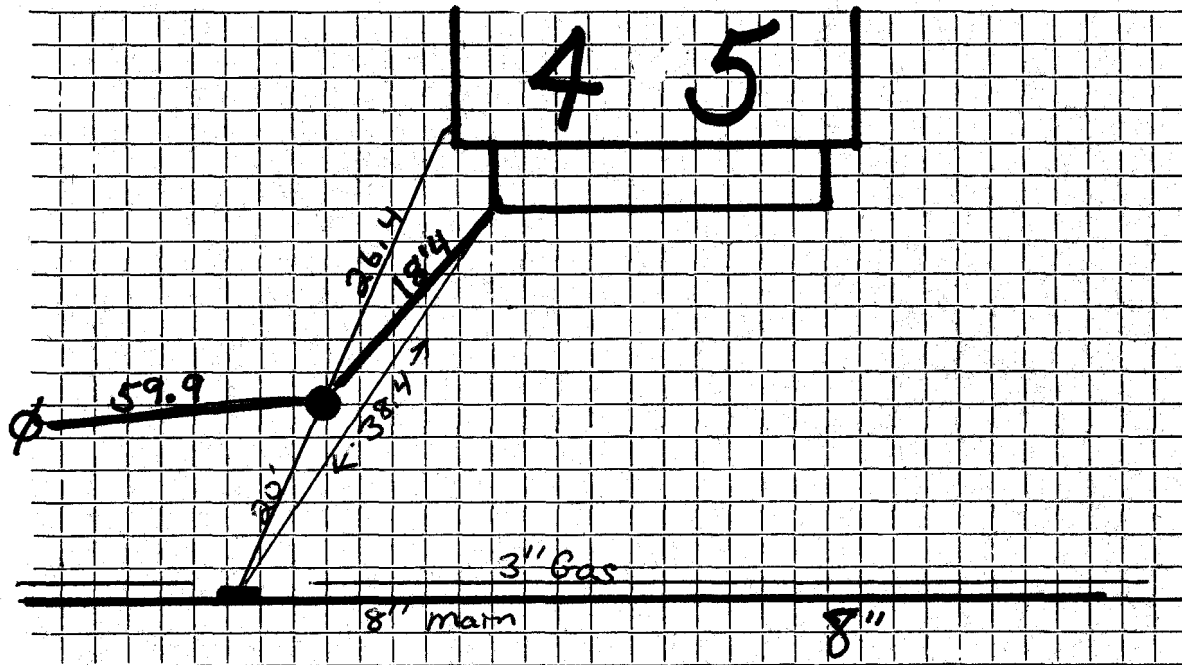

Old Corp.
Shut off
@ main

Connection made in Street. Work completed 9-22-94.....

Remarks: ..45° Elbow.. off.. Top.. of.. main.. goes.. under.. Gas.. .. 1-~~1~~X8 Repair Clamp with 1" c.c.
.. Old.. corp.. Shut.. off.. @.. main.. .. 3/4 copper.. to curb.. still.. hooked.. up..