








DATE \_\_\_\_\_

TOWN OF LEXINGTON — BOARD OF PUBLIC WORKS

WATER DIVISION

Sketch of Service Here

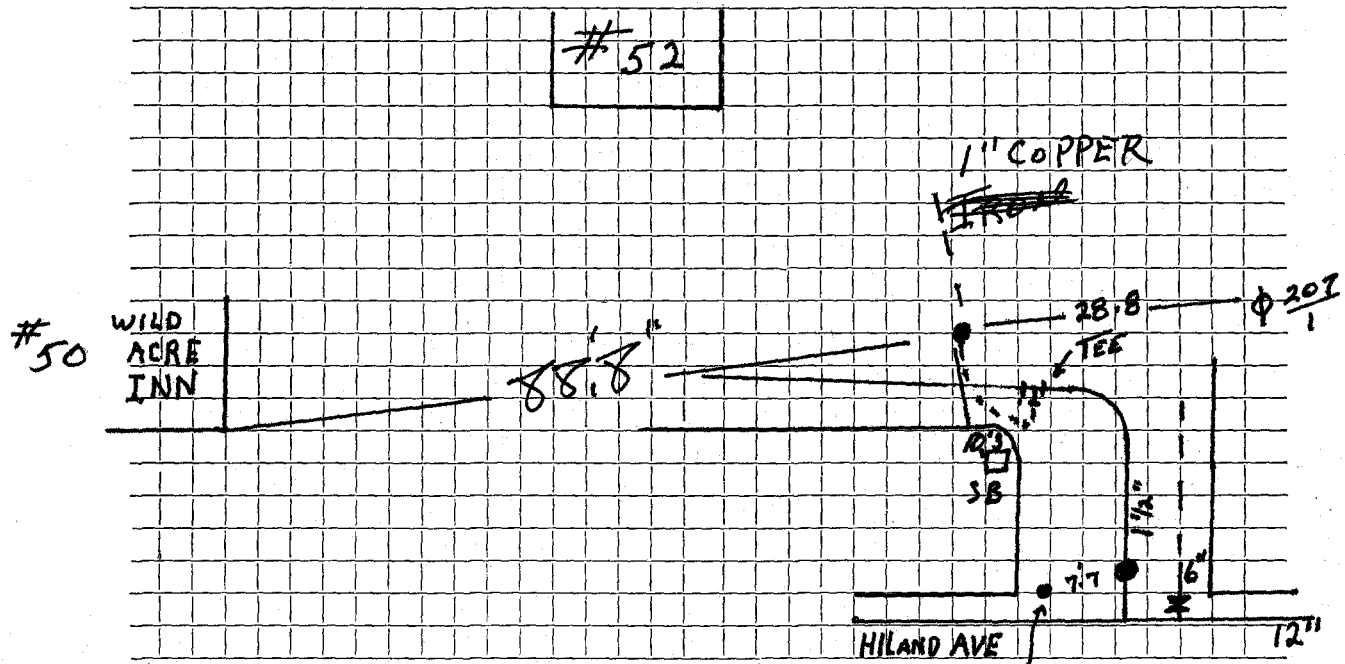

Connection made in ..... Street.

Work completed ..... 1" CURB OFF FOR 52 COPPER.....

Remarks: .....

.....

.....