

WATER SERVICE RECORD

Name *Homes Realty Corp.*

Service No.

Address *6 Percy Road*

Location


Repair—Renewal—New Service *Ed Banks #0022*

Date	Material	Amount	Total	Date	Amount
<i>2/7/90</i>	<i>114' 1" Copper</i>				
				<i>11-21-89</i>	
				<i>114' 1" Copper</i>	
				<i>1 1" C. Corp Cock</i>	
				<i>1 1" C. Curb Cock</i>	
				<i>1 1" Union</i>	

DATE 9-12-'90

TOWN OF LEXINGTON — BOARD OF PUBLIC WORKS
WATER DIVISION

Sketch of Service Here

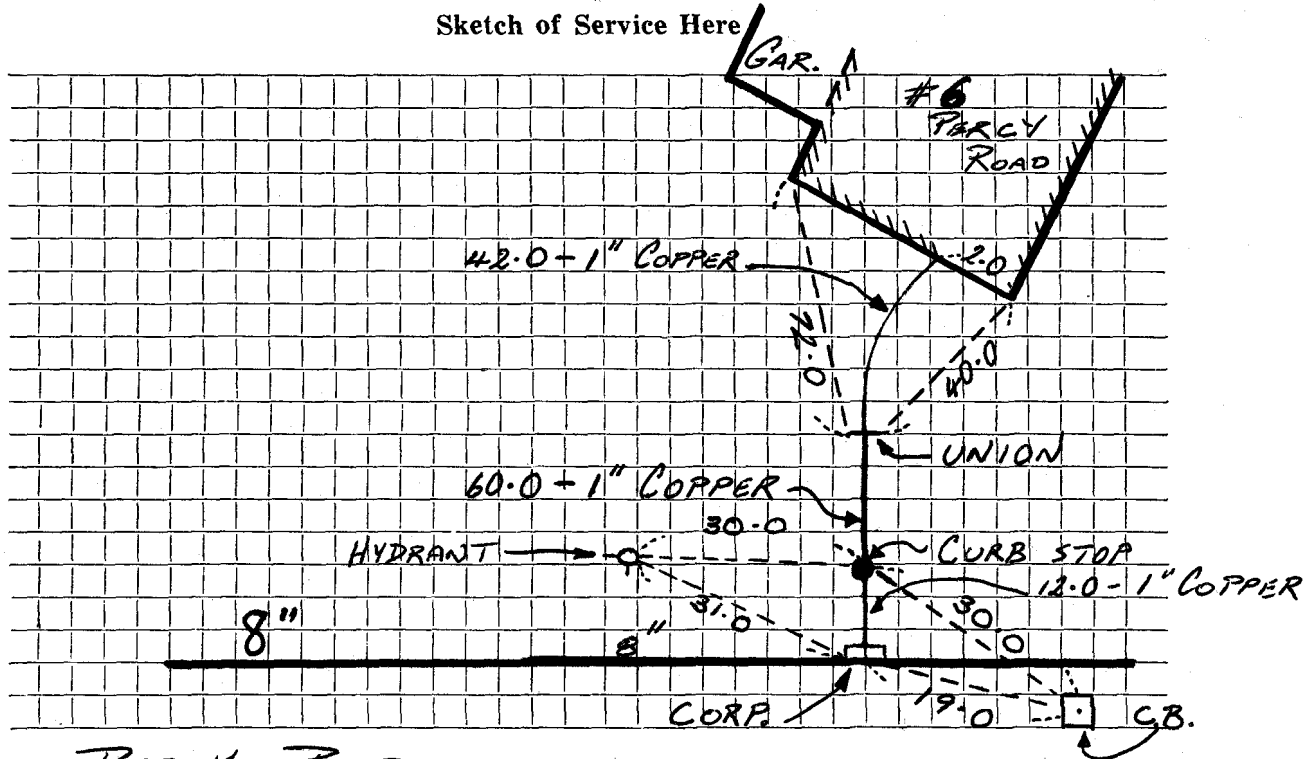

Connection made in PERCY ROAD Street. Work completed

Remarks:

.....

.....