


DATE 6-6-01

TOWN OF LEXINGTON — BOARD OF PUBLIC WORKS
WATER DIVISION

Sketch of Service Here

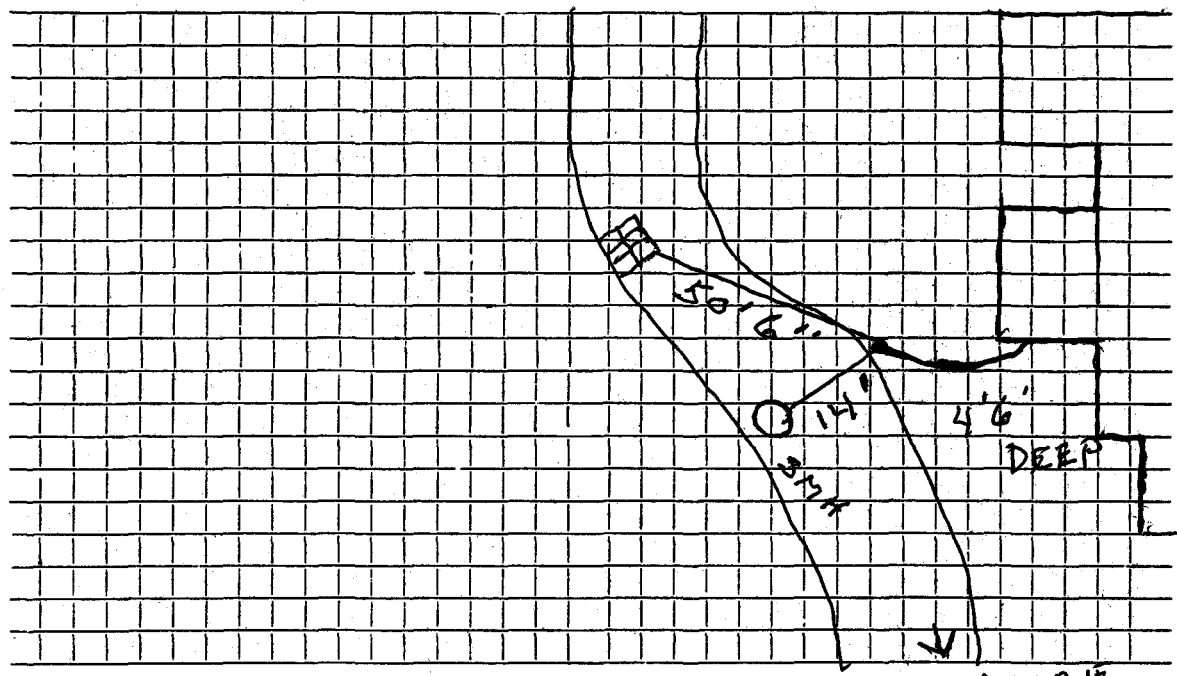

7 PERCY

Connection made in PERCY Rd Street. Work completed MASSAUE

Remarks: INSTALLED BY TOCCI CONS.