








DATE \_\_\_\_\_

# TOWN OF LEXINGTON — BOARD OF PUBLIC WORKS

## WATER DIVISION

BARN

Sketch of Service Here

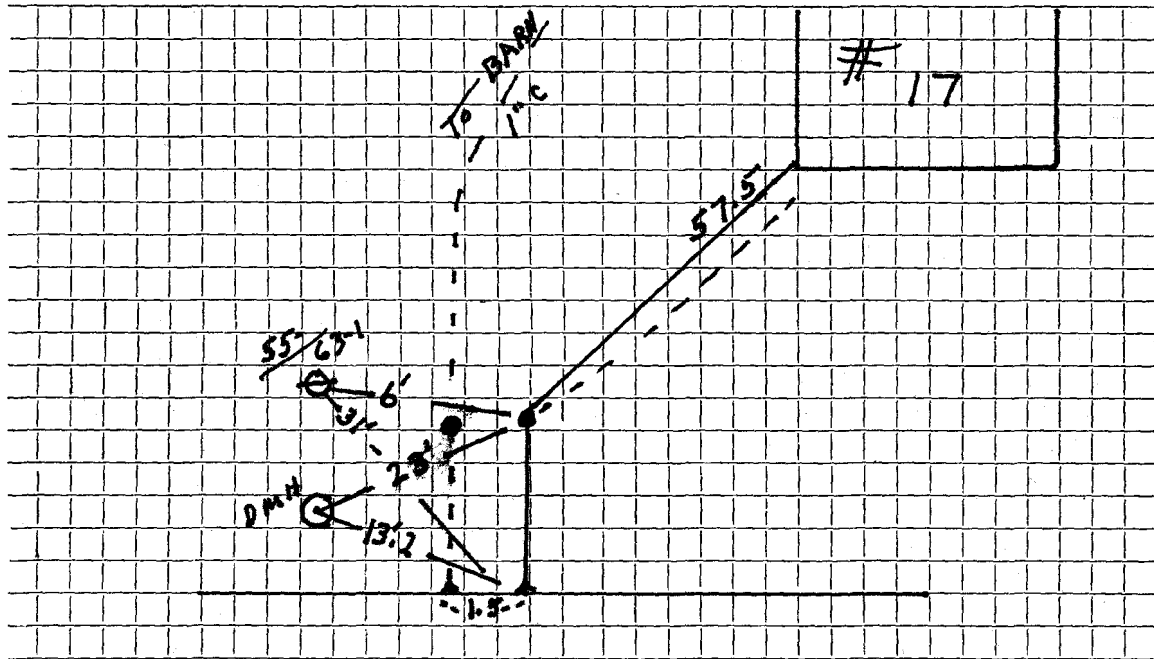

Connection made in PLEASANT LA Street. Work completed .....

Remarks: CURB BOXES 12.5" APART .....

.....

.....



