




DATE \_\_\_\_\_

TOWN OF LEXINGTON -- BOARD OF PUBLIC WORKS

**WATER DIVISION**

Sketch of Service Here

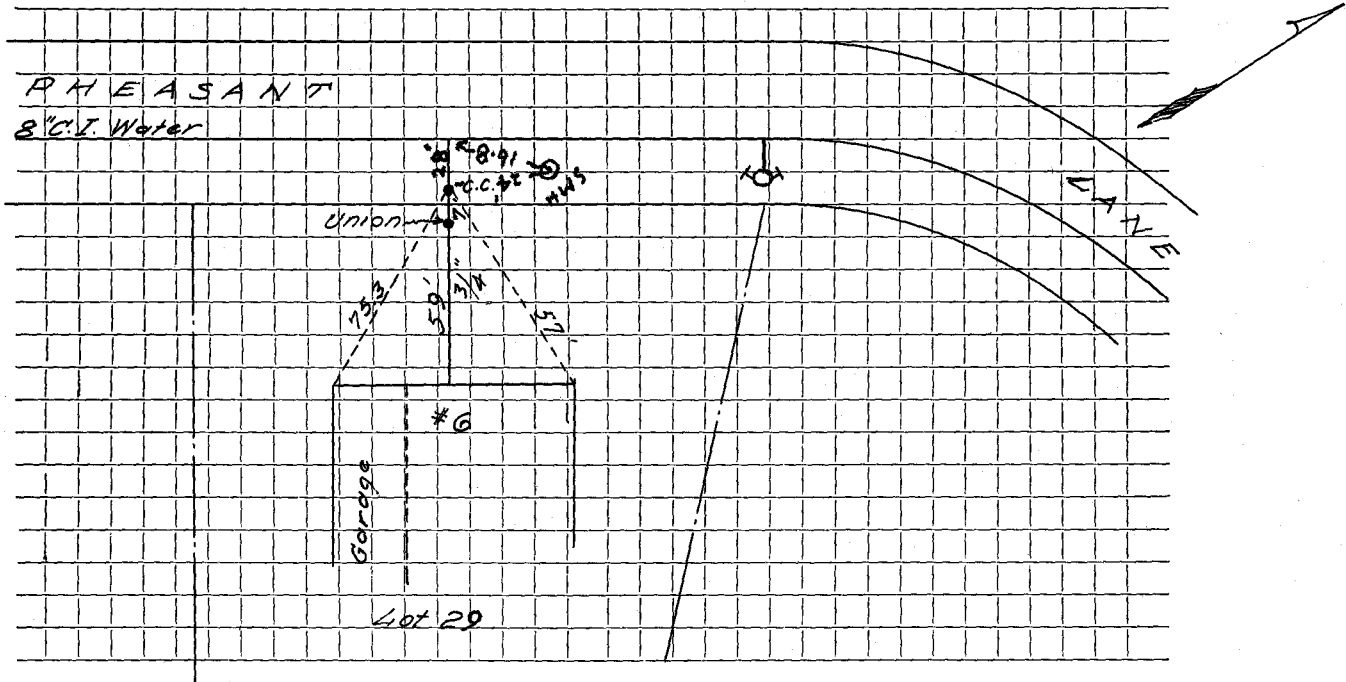

Connection made in ..... Street. Work completed .....

Remarks: .....  
.....  
.....