


DATE _____

TOWN OF LEXINGTON — BOARD OF PUBLIC WORKS

WATER DIVISION

Sketch of Service Here

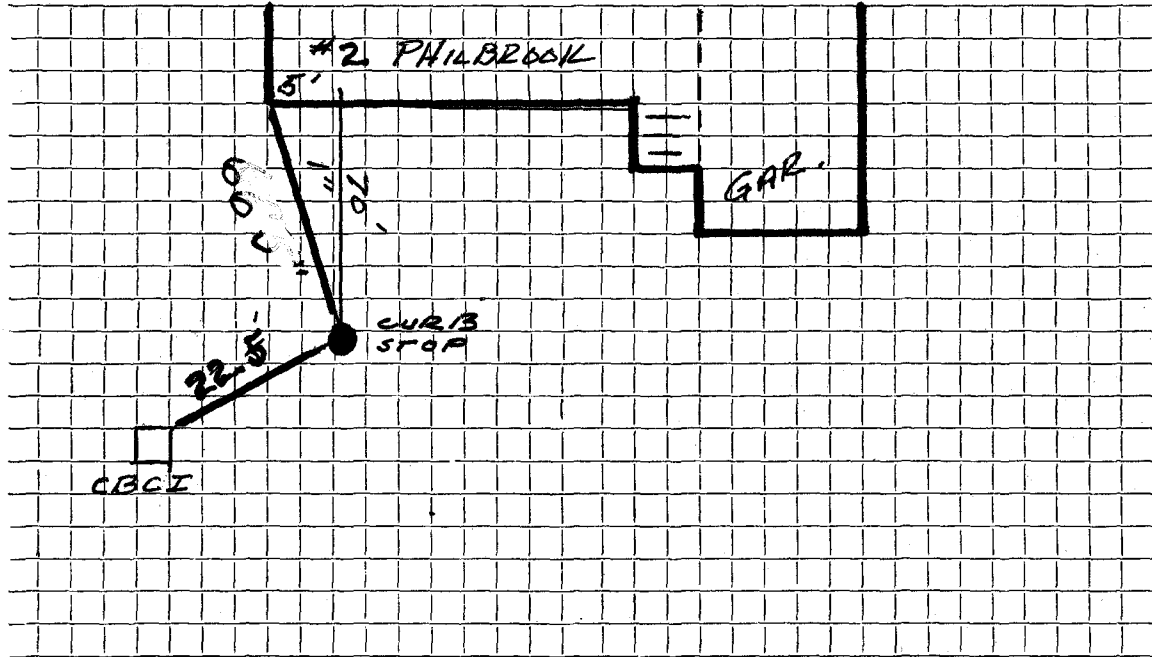

Connection made in PHILBROOK TERRACE Street. Work completed

Remarks: NO OUTSIDE TIES - Subdivision