


DATE _____

TOWN OF LEXINGTON — BOARD OF PUBLIC WORKS

WATER DIVISION

Sketch of Service Here

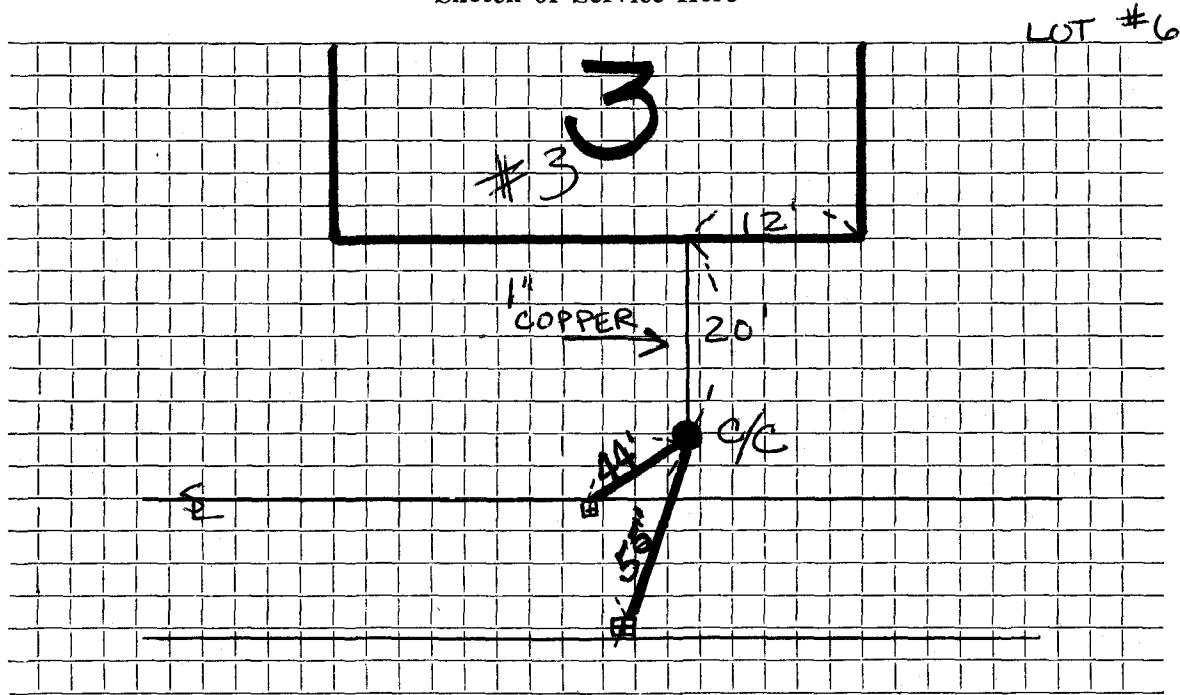

Connection made in PHILBROOK Street. Work completed

Remarks: NOTE: NO OUTSIDE TIES

.....
.....