


DATE _____

TOWN OF LEXINGTON — BOARD OF PUBLIC WORKS

WATER DIVISION

Sketch of Service Here

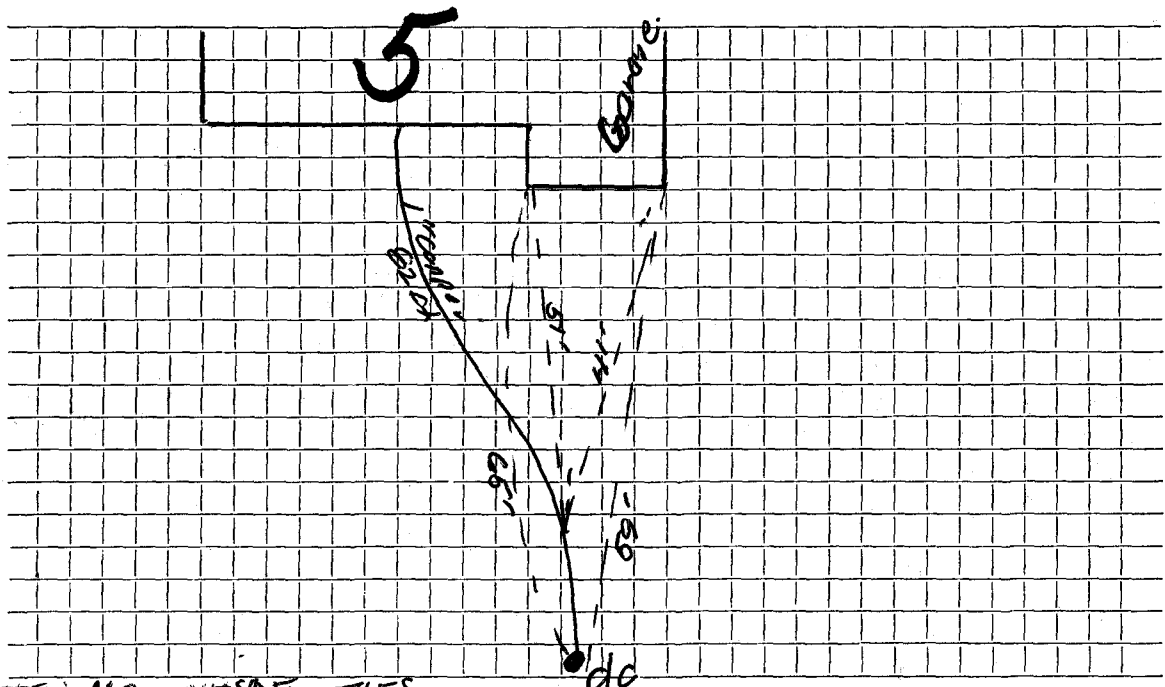

NOTE: NO OUTSIDE TIES

Connection made in PHILBROOK TERR. Street.

Work completed

Remarks:

.....

.....