


DATE _____

TOWN OF LEXINGTON — BOARD OF PUBLIC WORKS

WATER DIVISION

Sketch of Service Here

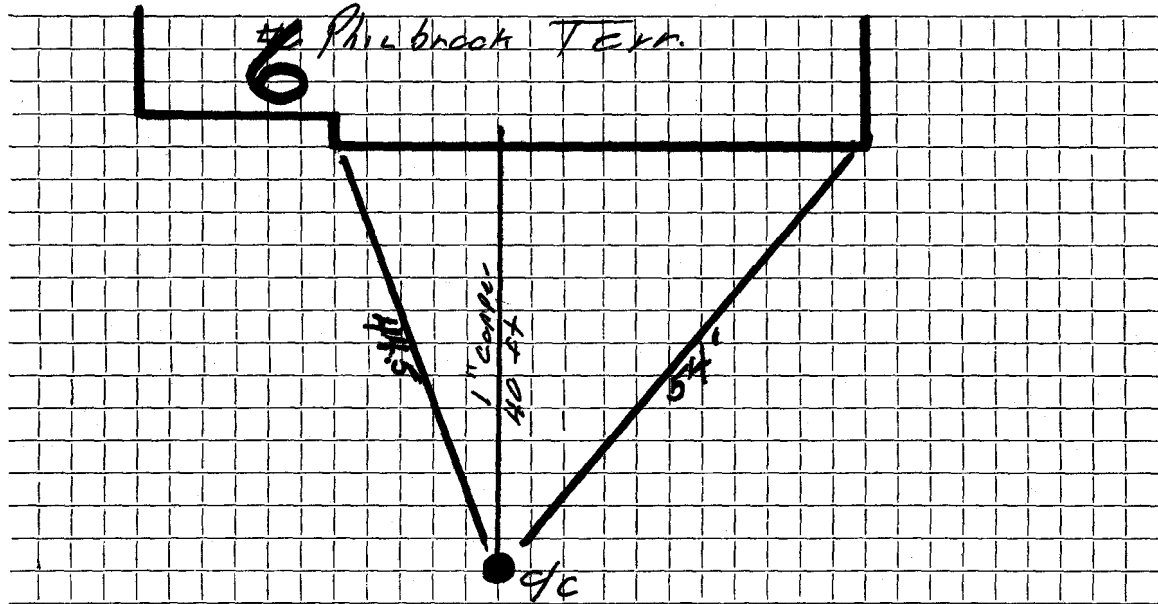

NOTE: NO OUTSIDE TIES

Connection made in PHILBROOK TERR... Street.

Work completed 7/13/68

Remarks:
.....
.....