


DATE 10/20/12

TOWN OF LEXINGTON — BOARD OF PUBLIC WORKS

WATER DIVISION

Sketch of Service Here

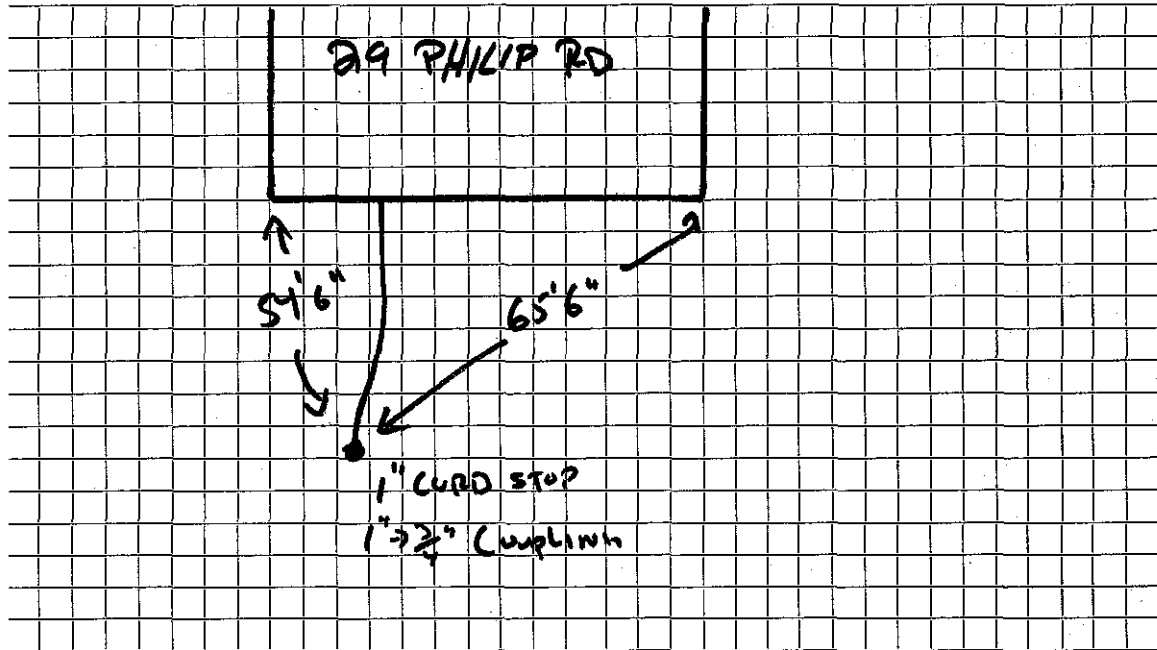

Connection made in PHILIP Street. Work completed LAKE SIDE EXCAVATION

Remarks:

.....

.....