




Date: 10/7/22

TOWN OF LEXINGTON - BOARD OF PUBLIC WORKS  
WATER DIVISION

SKETCH OF SERVICE HERE

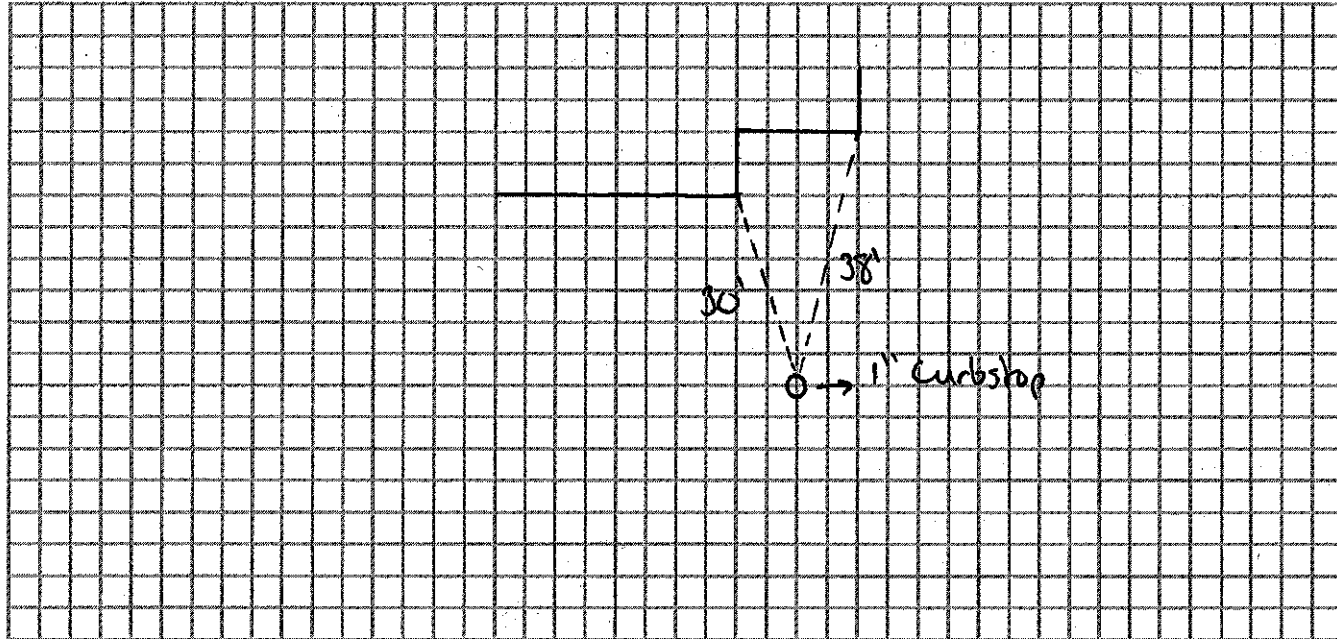

Connection made in:

Street:

Work completed:

Remarks: INSTALLED By SPEEDWAGON PARTNERS