

WATER SERVICE RECORD

Name

Service No.

Address 4 Philip Road (lot 74)

Location

~~Repair~~ ~~Renewal~~ New Service SERVICE TO CURB

Date	Material	Amount	Total	Date	Amount
3-17-54	75' 3/4" Copper				
	1 3/4" C. X 1/2" I.W.H. Stop + Waste			10/25/52	
	1 3/4" C. X 3/4" C. - 3 Part Union				
					<u>NON CHARGE</u>
					Labor
					4 67
					21' - 3/4" Copper tubing @ .34
					7 14
					1 - 3/4" C. corp-cock
					4 33
					1 - 3/4" C x 3/4" C. curb-cock
					4 67
					1 box and rod
					3 90
					1 hr. trucking
					75
					<u>25 46</u>


DATE \_\_\_\_\_

# TOWN OF LEXINGTON — BOARD OF PUBLIC WORKS

## WATER DIVISION

Sketch of Service Here

W.S. Form # 4

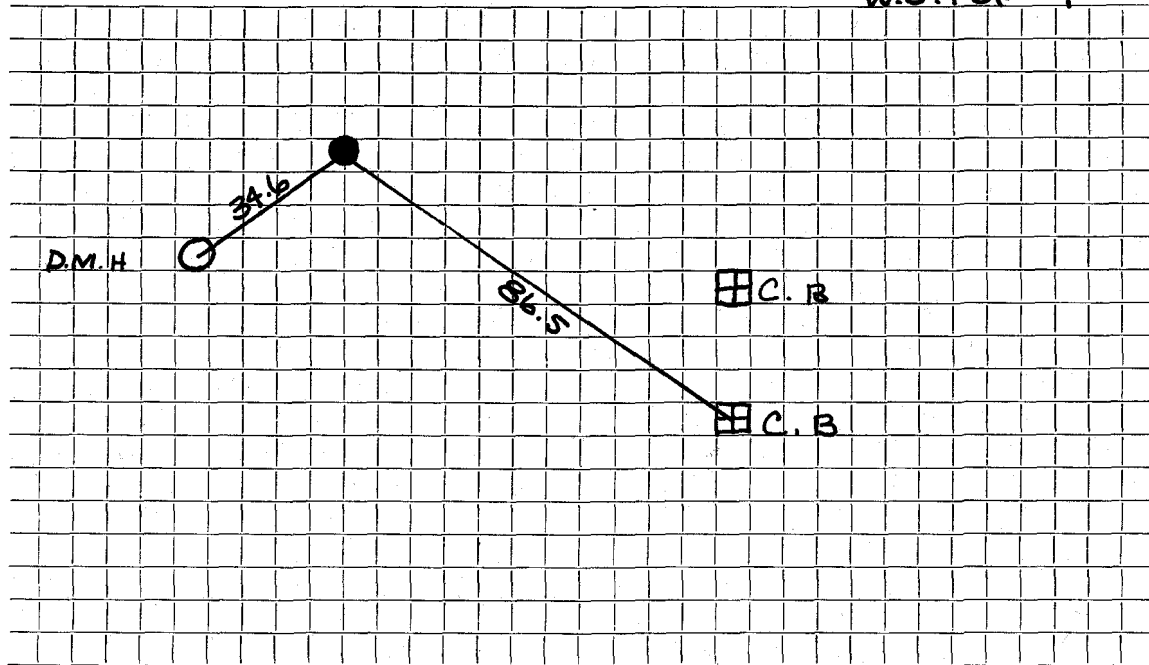

Connection made in ..... Street. Work completed .....

Remarks: .....  
.....  
.....