

WATER SERVICE RECORD

Name

Service No.

Address

5 Philip Rd.
~~Eastland Lane (Lot 90)~~

Location

~~Repair - Renewal~~ New Service SERVICE TO CURB


Date	Material	Amount	Total	Date	Amount
12-8-53					
	60' $\frac{3}{4}$ " Copper				<u>NON CHARGE</u>
	1 $\frac{3}{4}$ " C. X $\frac{1}{2}$ " I.W.H. Stop & Waste			10/25/52	Labor 4 66
					7' - $\frac{3}{4}$ " Copper tubing @ /34 2 38
					1 - $\frac{3}{4}$ " C. corp-cock 4 33
					1 - $\frac{3}{4}$ " C x $\frac{3}{4}$ " C. curb-cock 4 67
					1 box and rod 3 90
					1 hr. trucking 75
					<u>20 69</u>

DATE _____

TOWN OF LEXINGTON — BOARD OF PUBLIC WORKS

WATER DIVISION

Sketch of Service Here

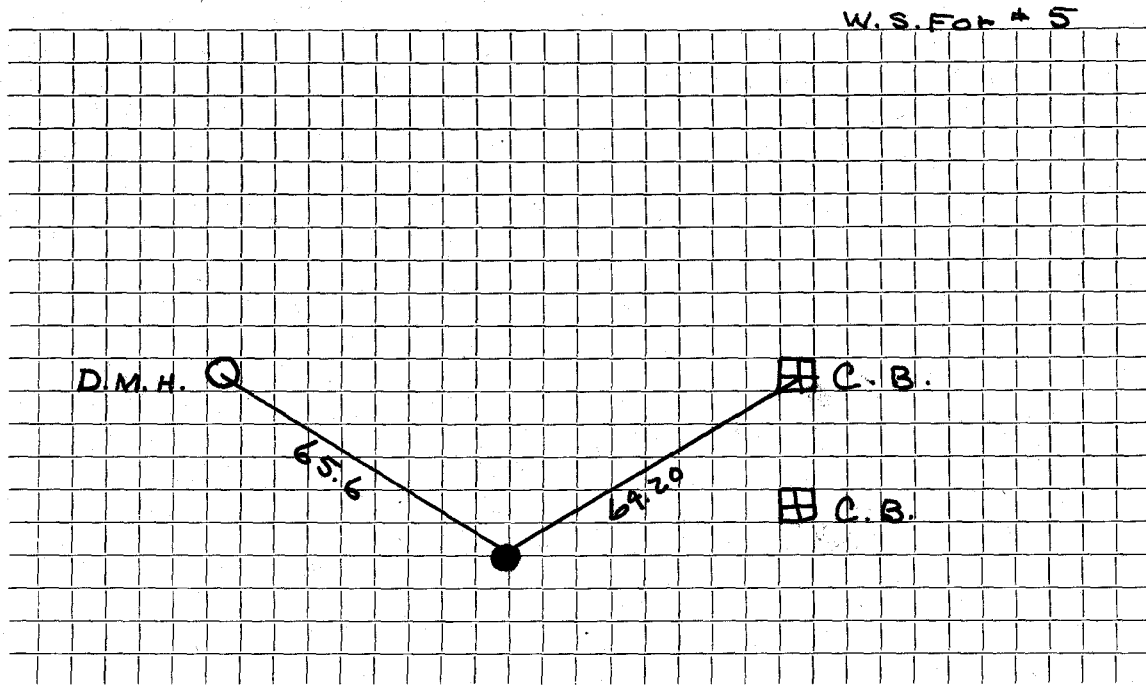

Connection made in Street. Work completed

Remarks:

.....

.....